



REFER TO SEJC. DRG.
501180C/20-002 FOR
ALL STEELWORK & PC.
CONCRETE NOTES.

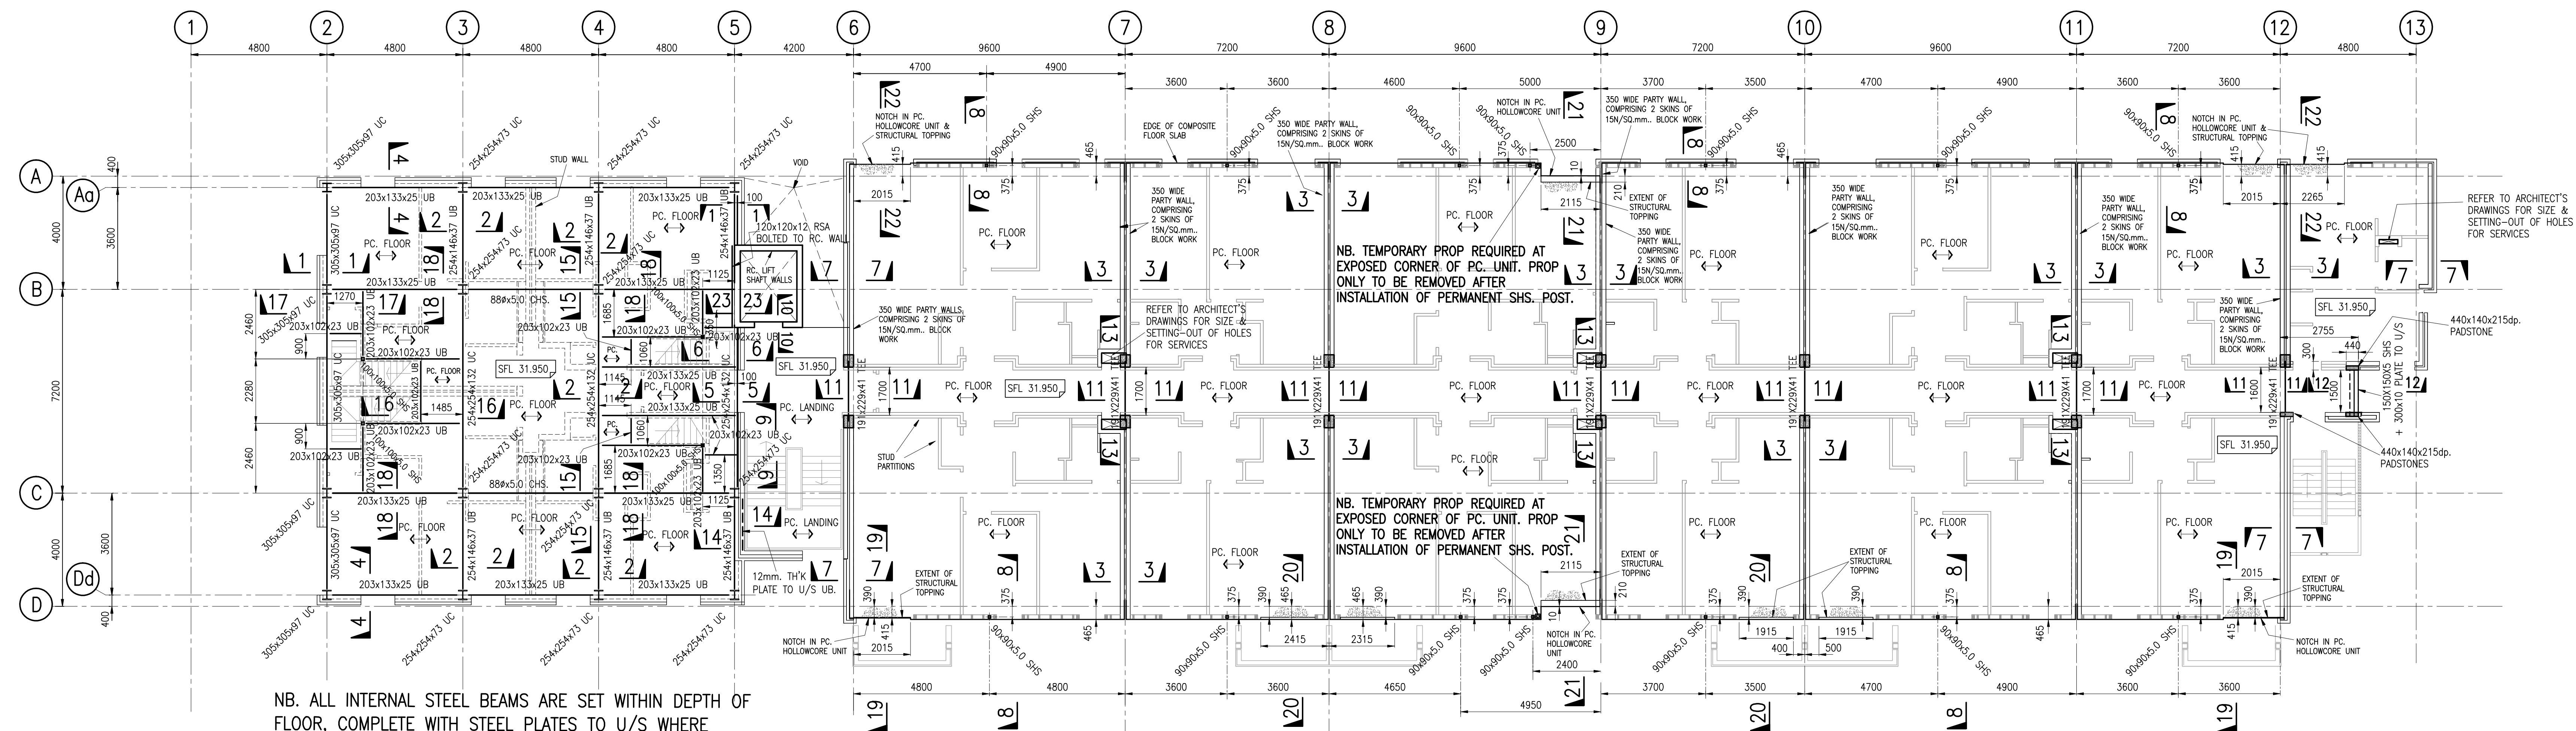

NB. ALL INTERNAL STEEL BEAMS ARE SET WITHIN DEPTH OF FLOOR, COMPLETE WITH STEEL PLATES TO U/S WHERE SUPPORTING PC. UNITS (CHS. TIES UNDERNEATH FLOOR) TOP OF EDGE BEAMS SET TO U/S OF PC. FLOOR.

NOTE: PC. HOLLOWCORE UNITS TO BE PROPPED AT MID-SPAN, PRIOR TO CASTING STRUCTURAL TOPPING, AND TO BE LEFT A MINIMUM OF 7 DAYS BEFORE REMOVAL.

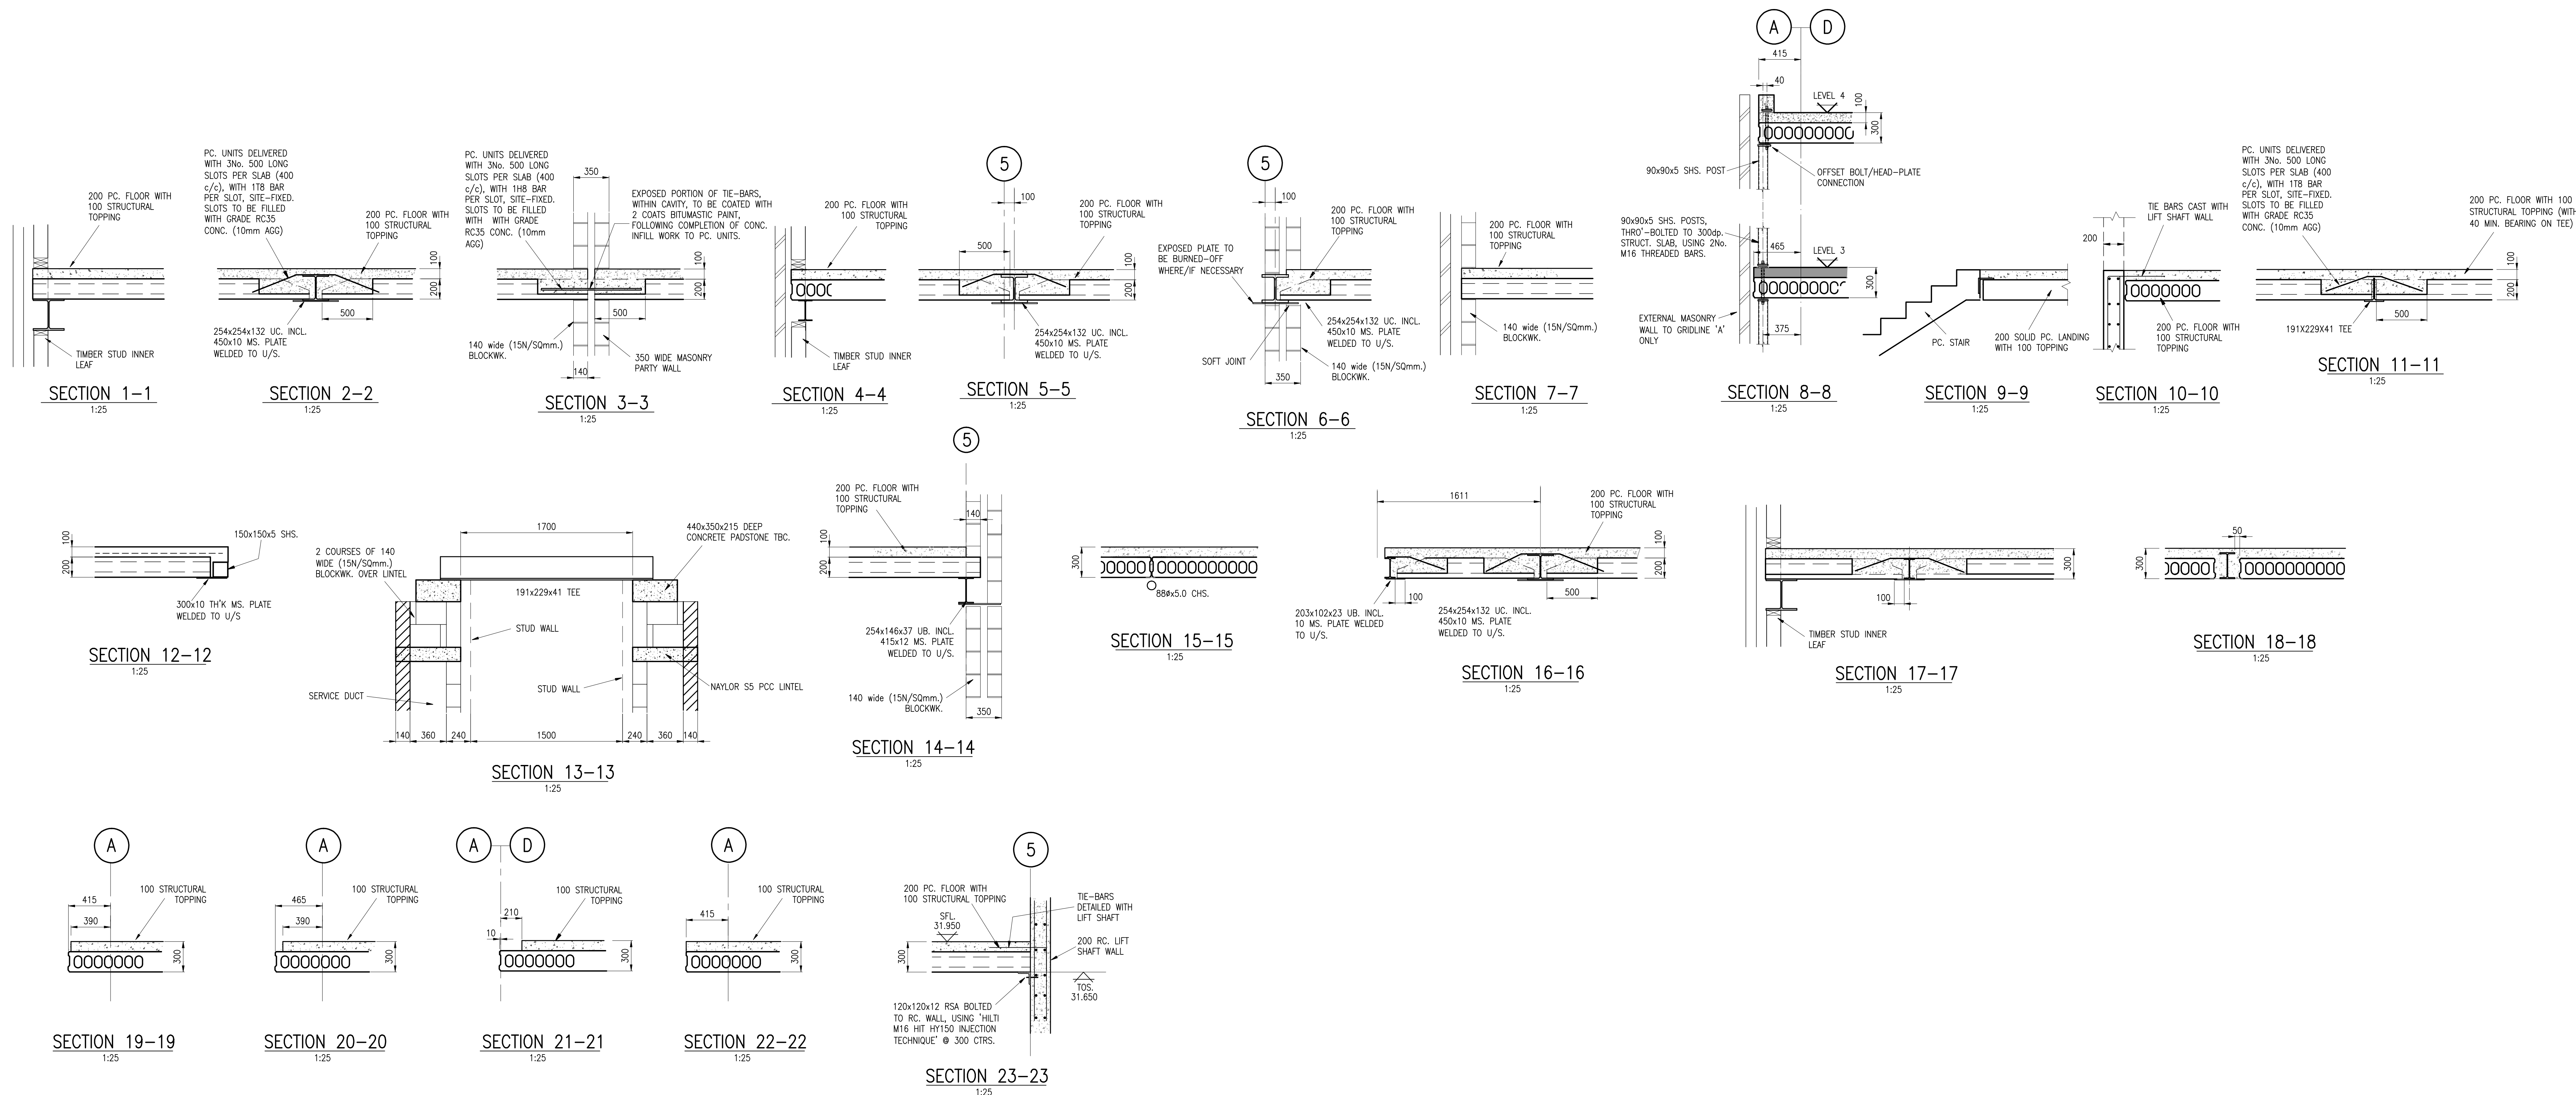

MK REVISIONS

IS

DATE

CHK


STATUS:-

AS-BUILT

DRAWN BY: - - - - - DATE: MAY '06
CHECKED BY: - - - - - DATE: - - - - -
PROJECT ENGINEER: - - - - - DATE: - - - - -

CLIENT
CTP ST. JAMES

PROJECT
WAKEFIELD WATERFRONT,
PHASE 1

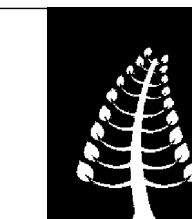

SEJC Consulting Engineers
Consulting Structural & Civil Engineers

Sanderson House, Station Road, Hornforth, Leeds LS18 5NT
Telephone 0113 2590090 Fax 0113 2590840

TITLE
GA. AT LEVEL 3, BUILDING 20

SCALE: 1:100 (NAD)

CONTRACT No.

501180C

DRG No.

20-004