



- CONCRETE NOTES**
1. ALL CONCRETE WORKMANSHIP TO COMPLY WITH S.E.C.C. CONSULTING ENGINEERS STANDARD AND ALL RELEVANT BRITISH STANDARDS.
 2. THE DRAWING TO BE READ IN CONJUNCTION WITH ALL RELEVANT ARCHITECTS AND S.E.C.C. CONSULTING ENGINEERS DRAWINGS.

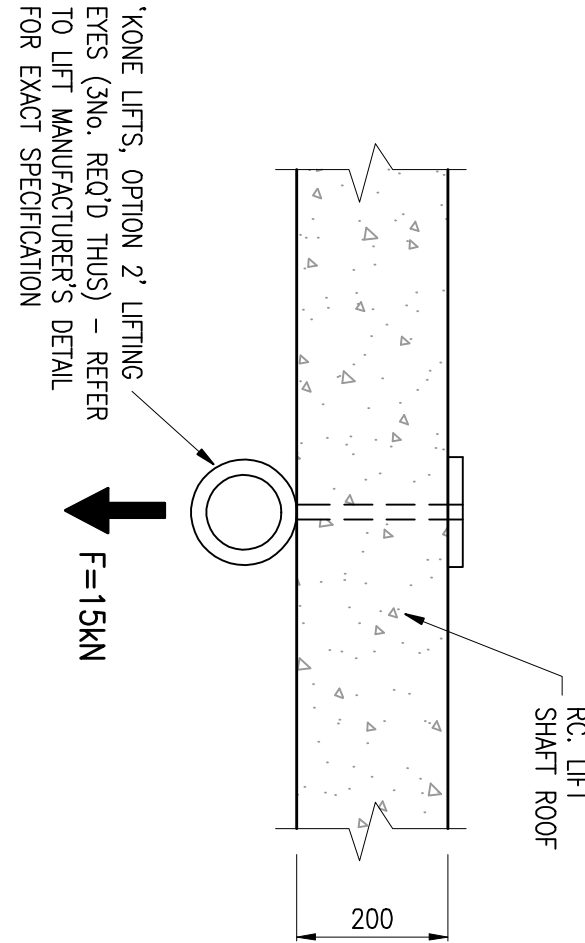


TYPICAL LIFTING EYE DETAIL


'KONE LIFTS, OPTION 2' LIFTING EYES - REFER TO LIFT MANUFACTURER'S DETAIL FOR EXACT SPECIFICATION

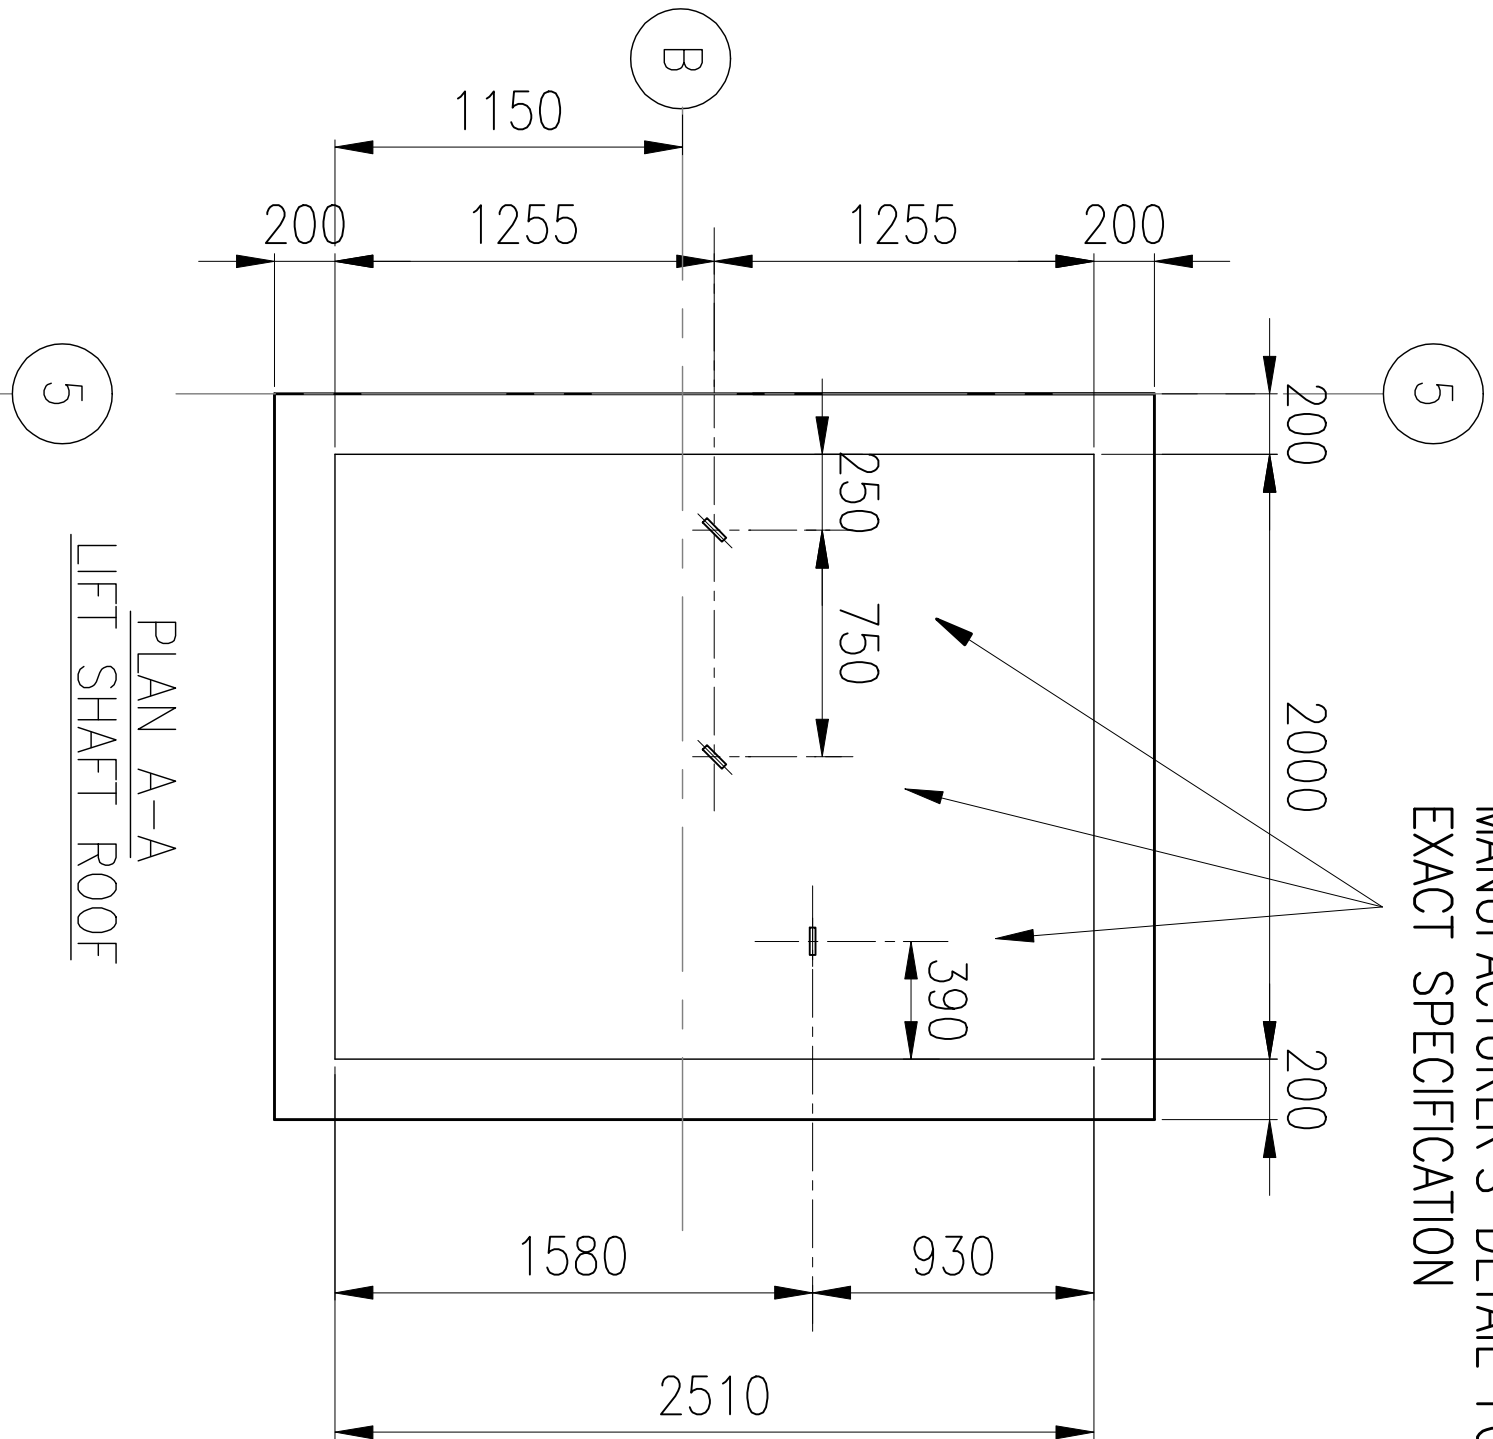


PLAN A--A
LIFT SHAFT ROOF

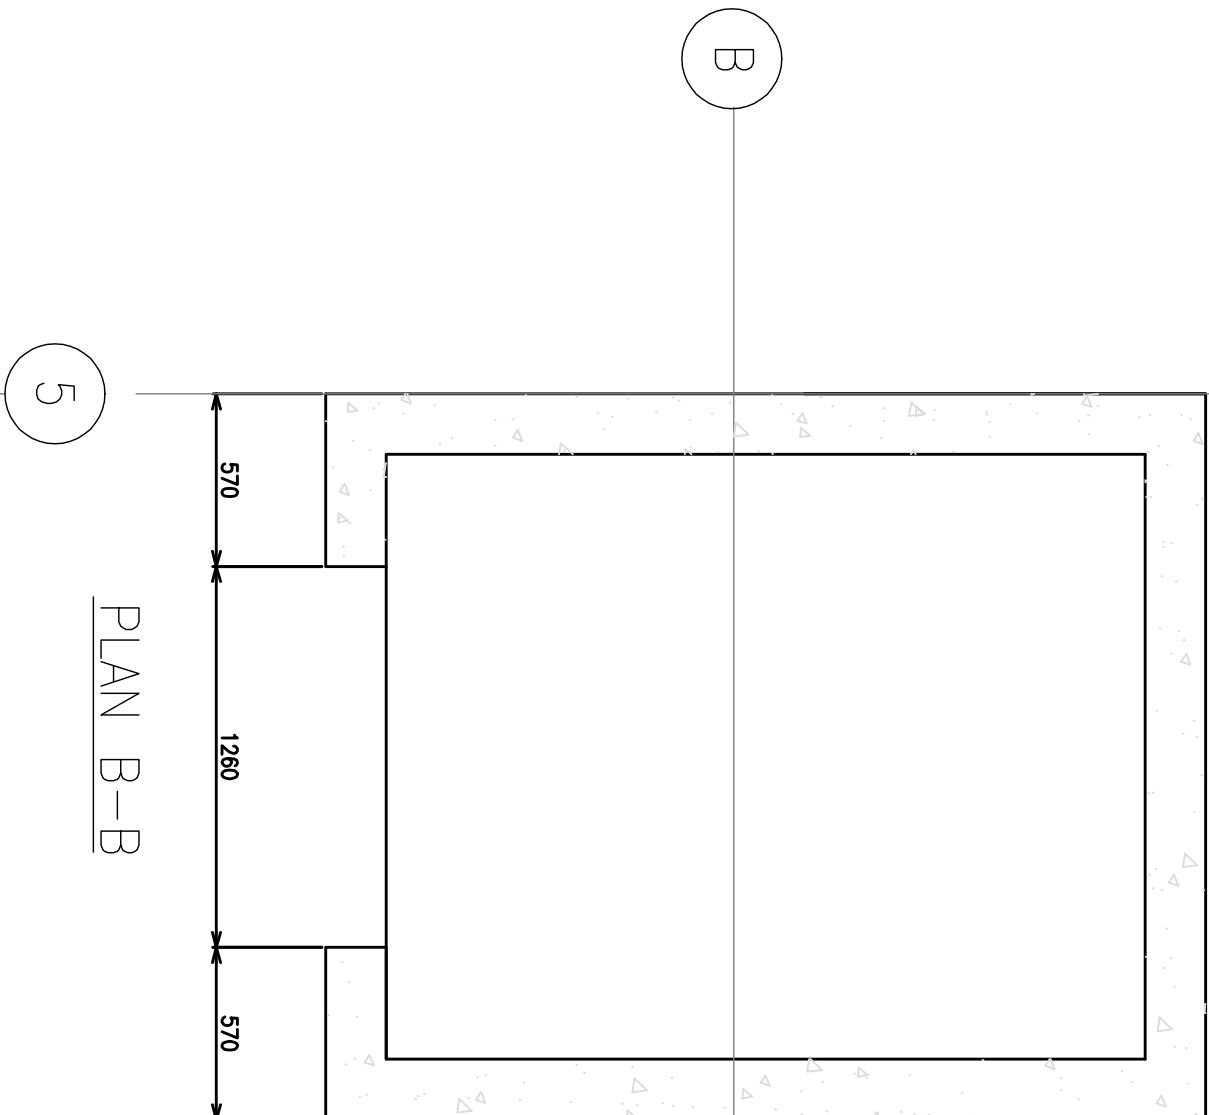


PLAN B--B

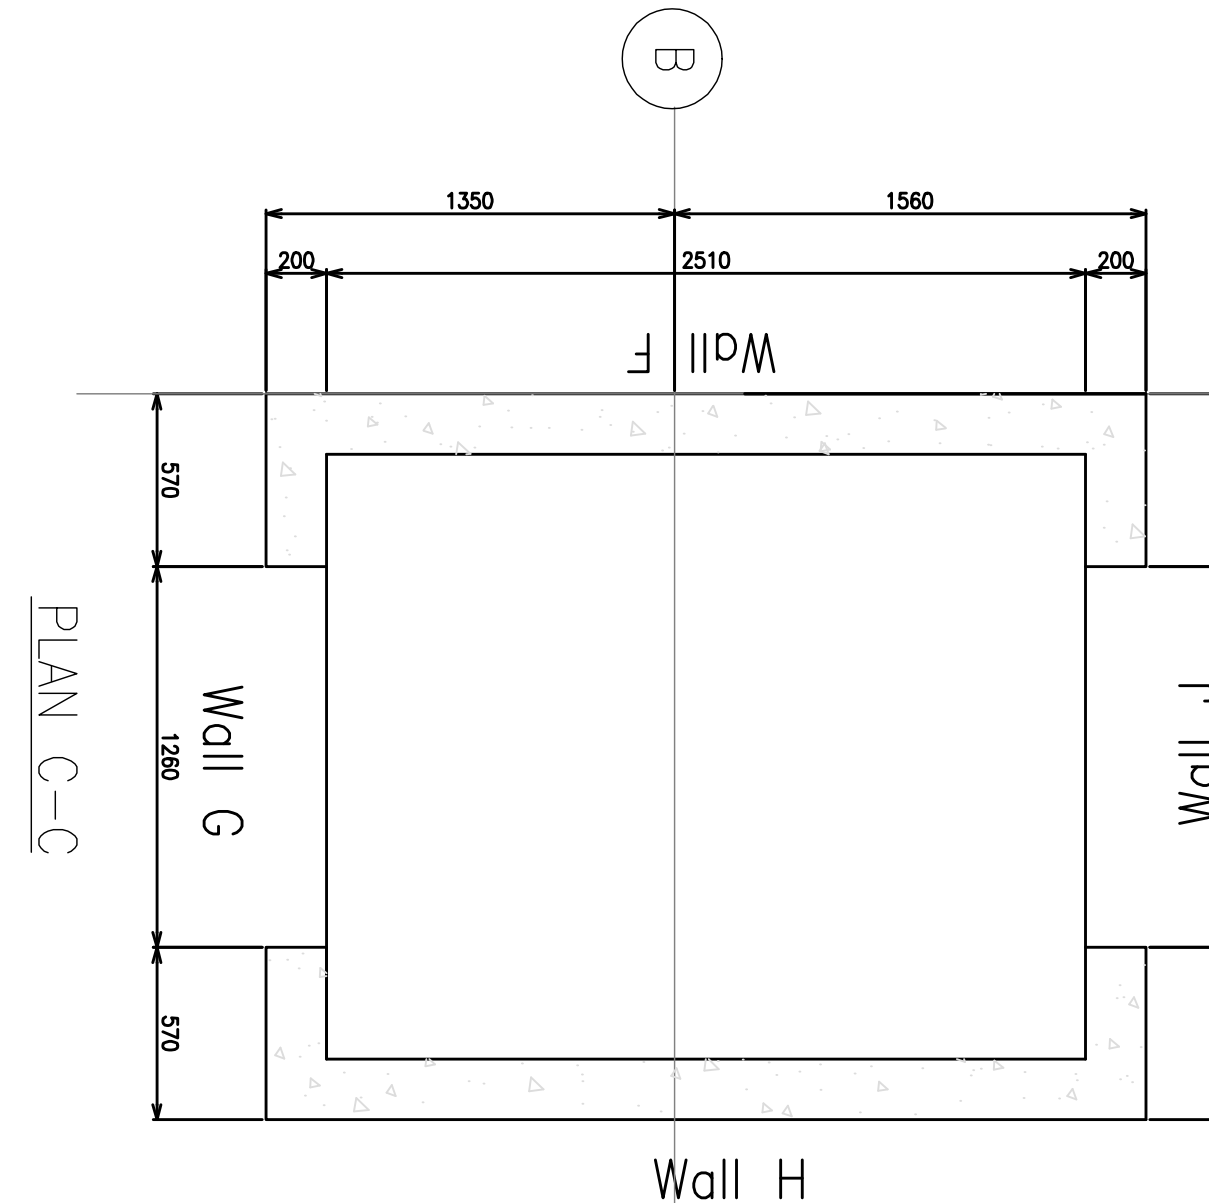


PLAN C--C

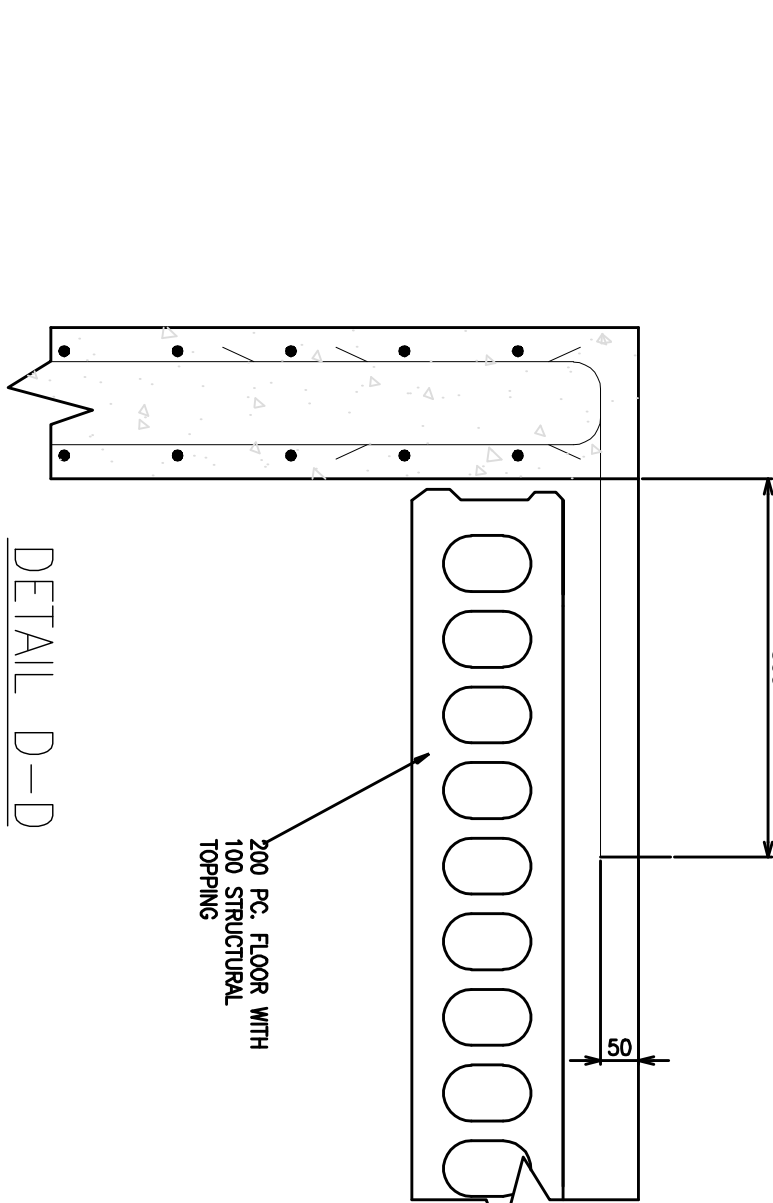


DETAIL D-D

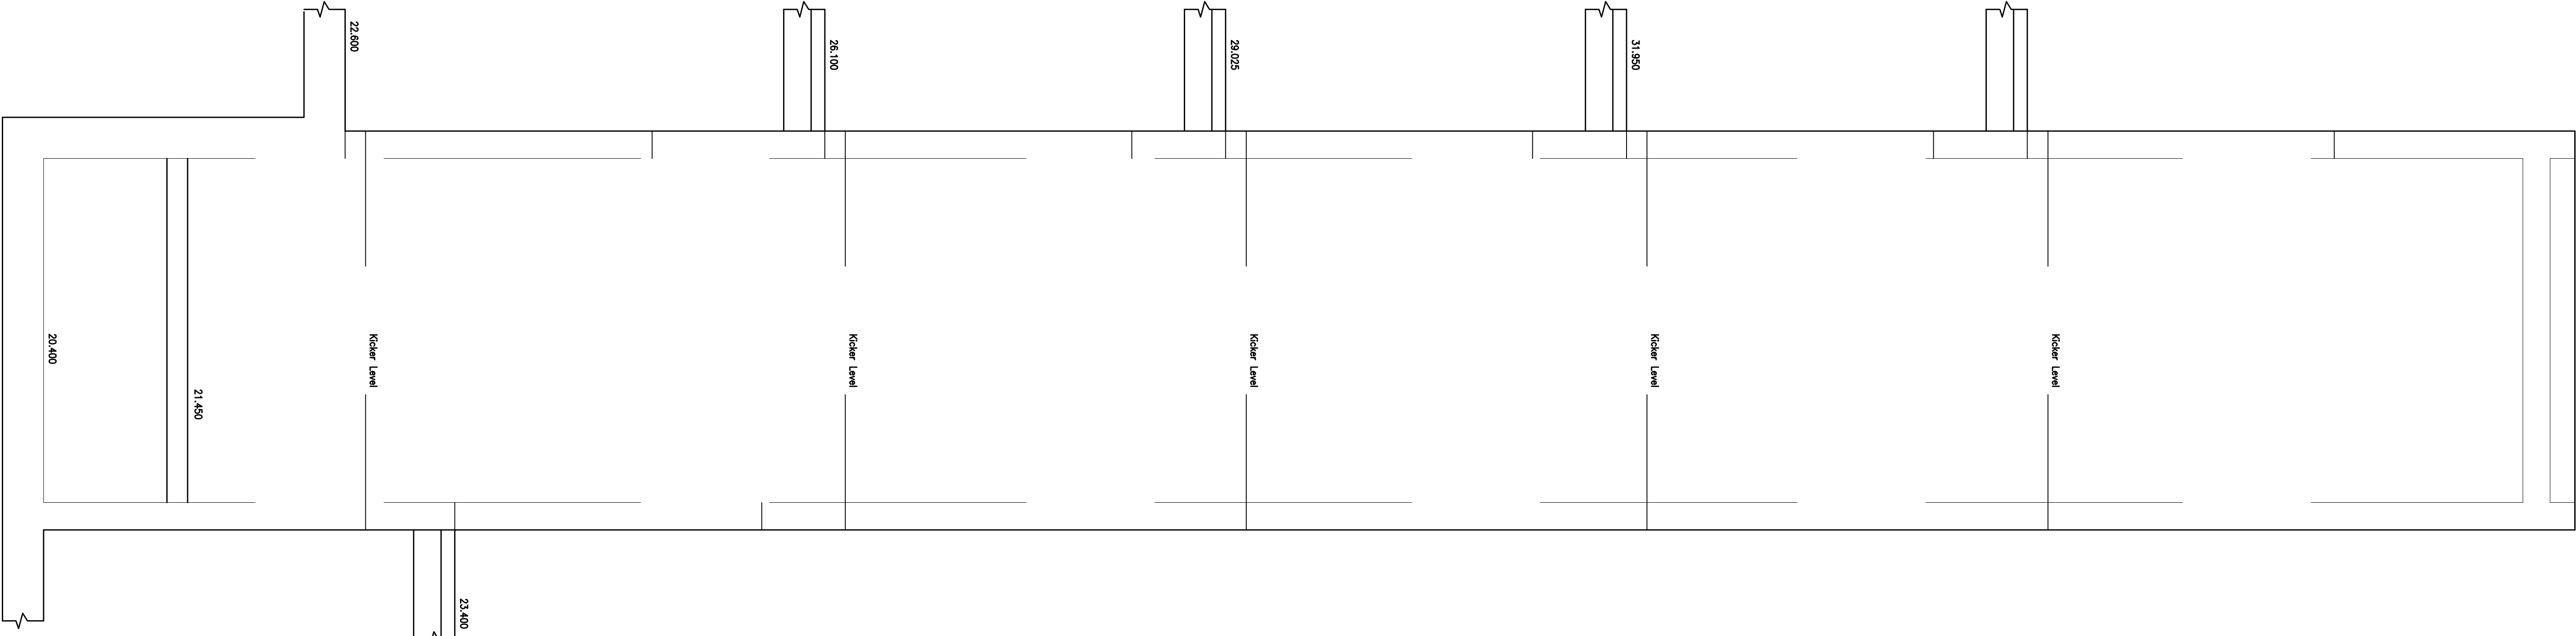


ELEVATION ON WALL H

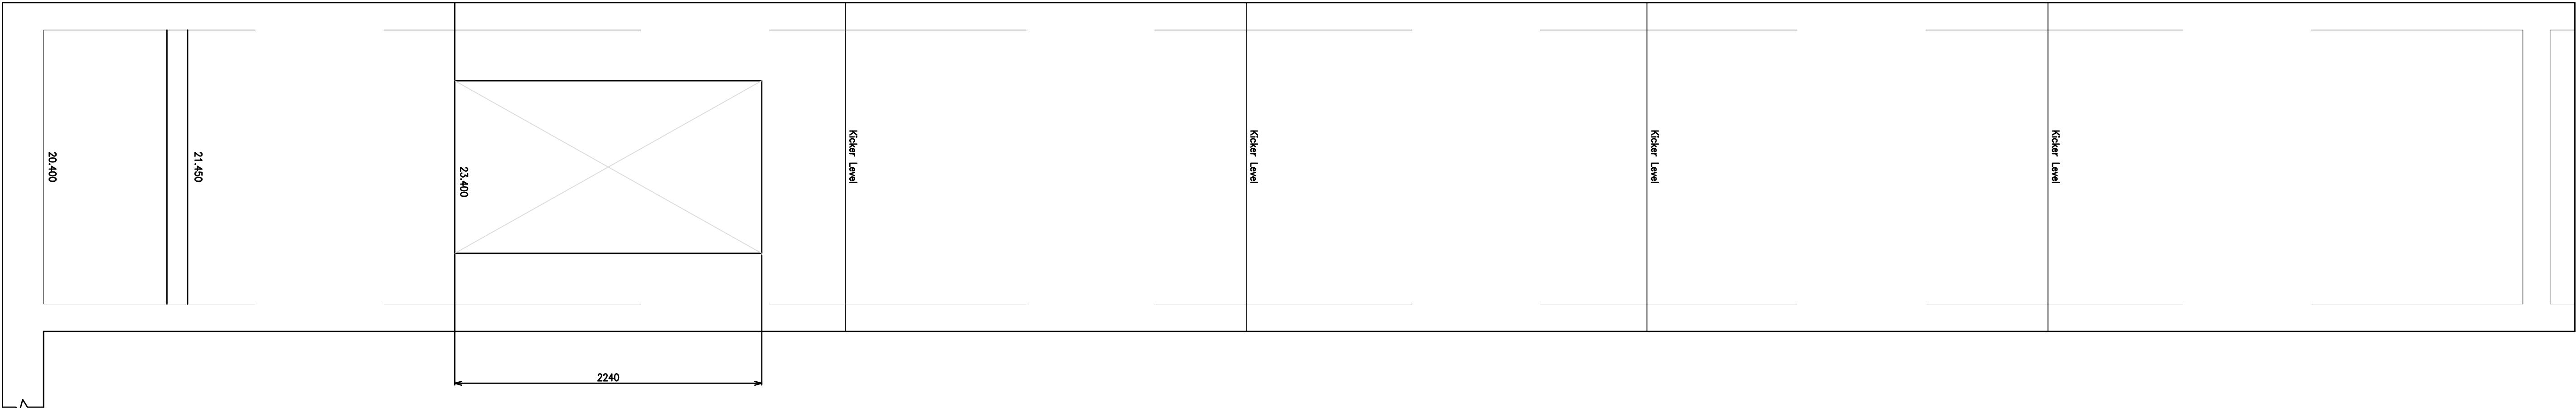

ELEVATION ON WALL J

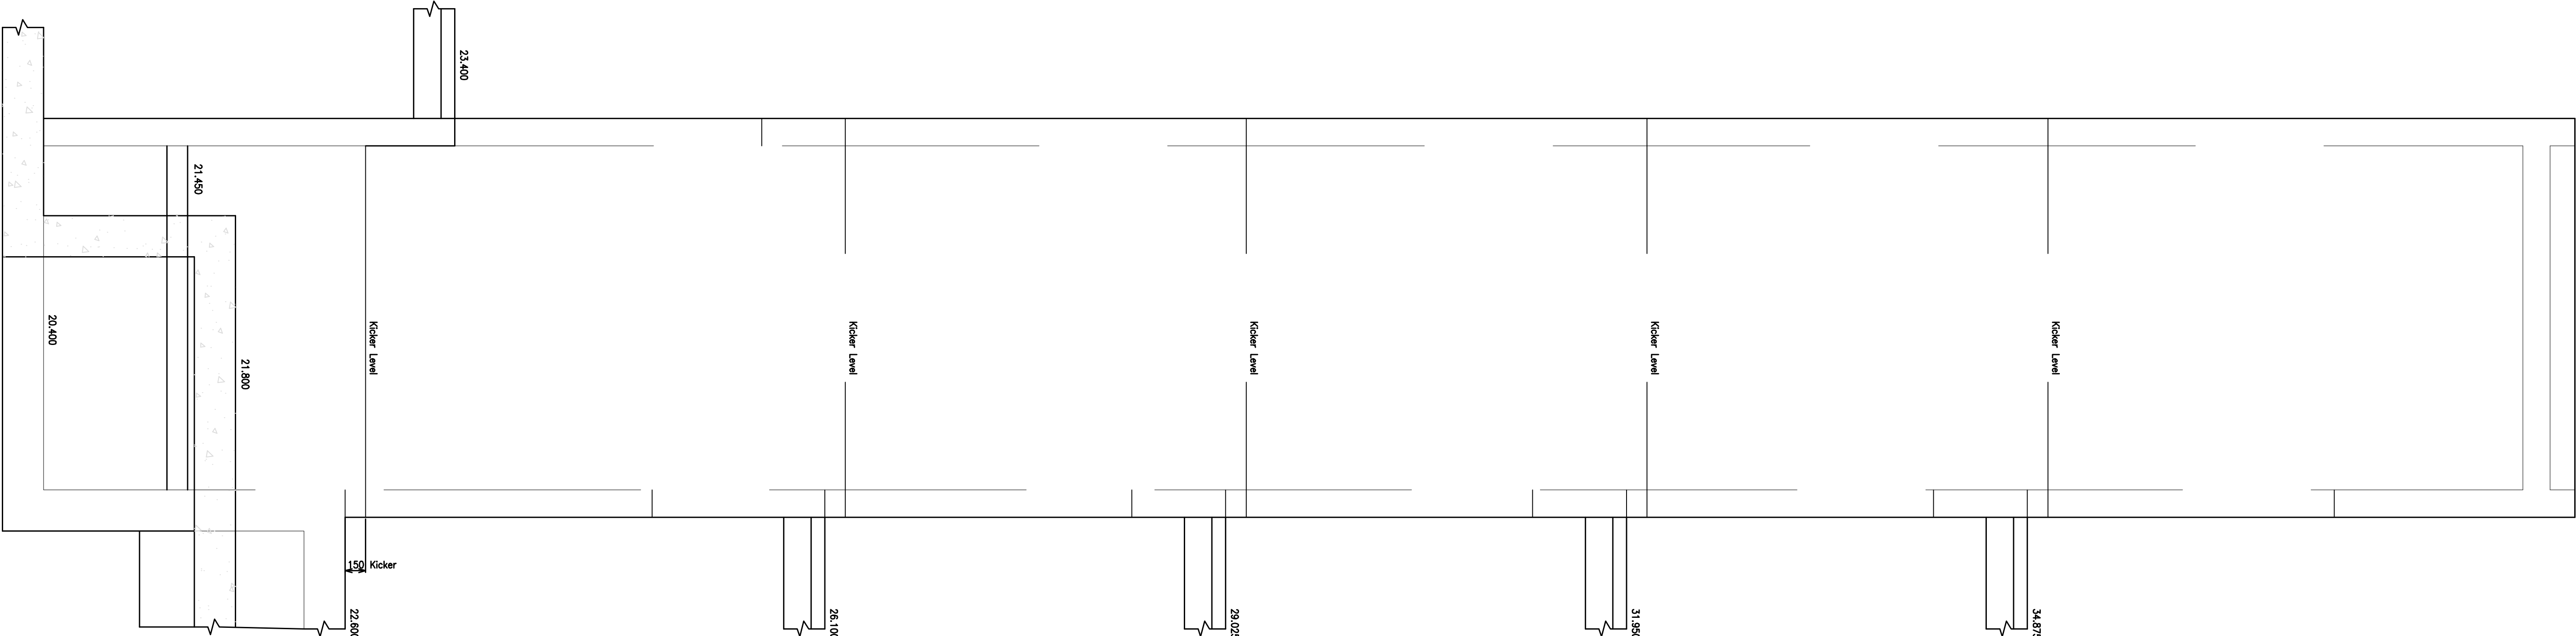

ELEVATION ON WALL F

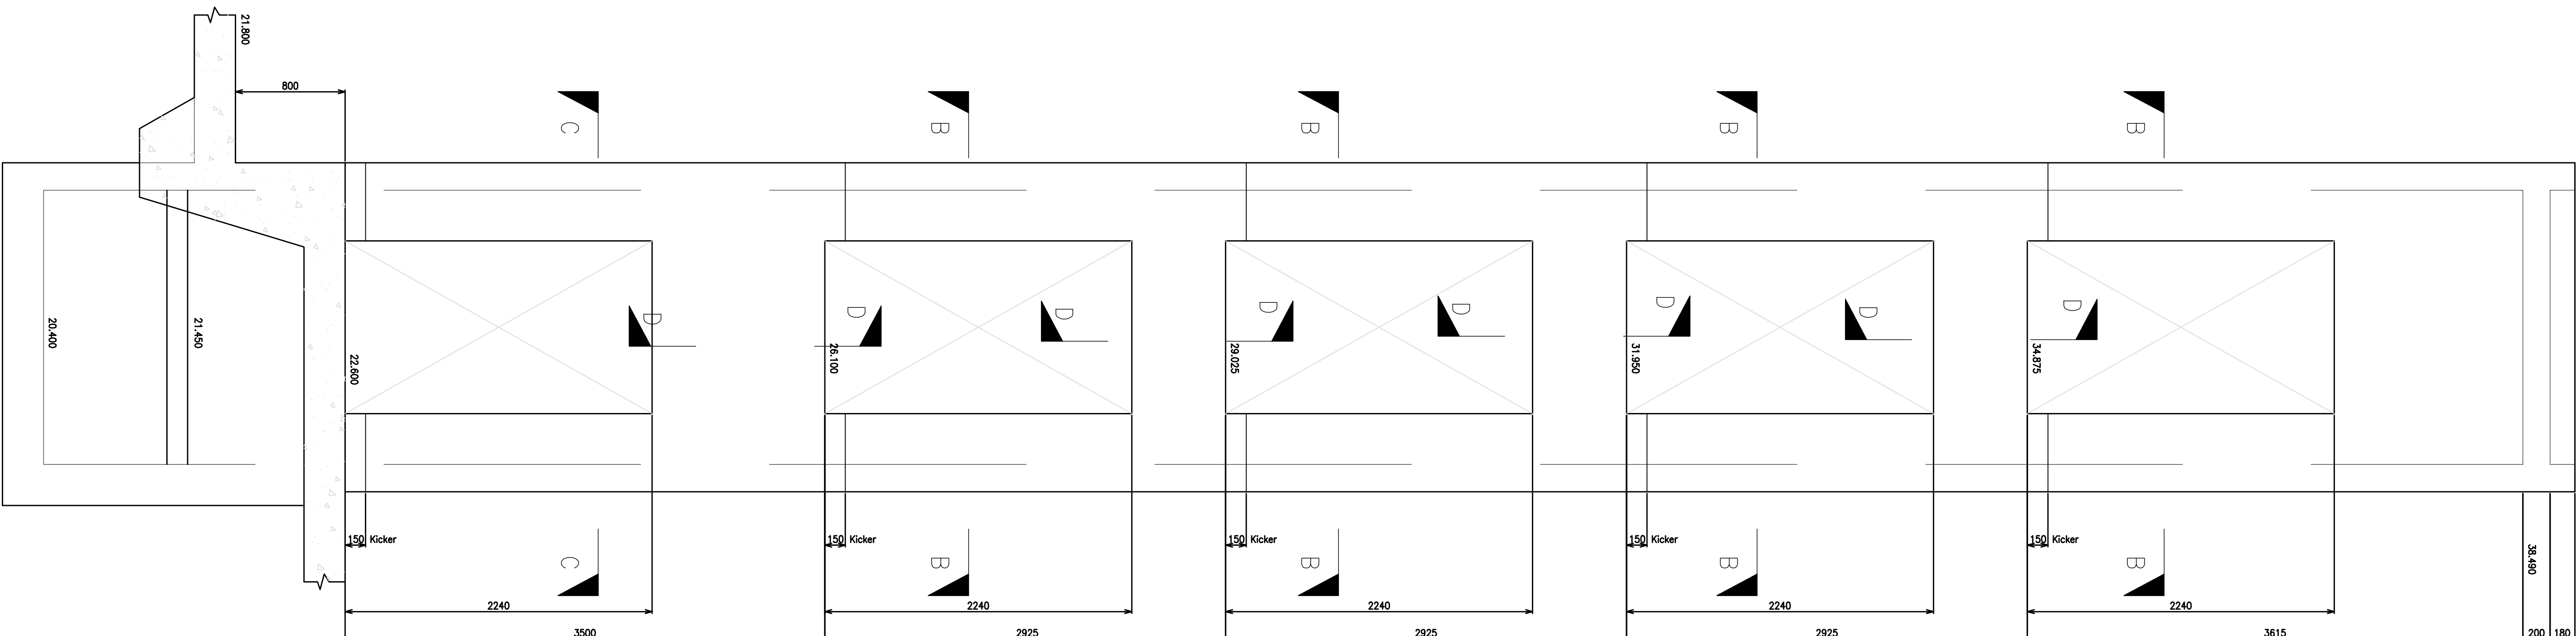

ELEVATION ON WALL G



SEJC Consulting Engineers
Consulting Structural & Civil Engineers
100, 101, 102, 2018, 2019