



SECTION A-A.
1:10. SECTION B-B SIMILAR
BUT HANDED.

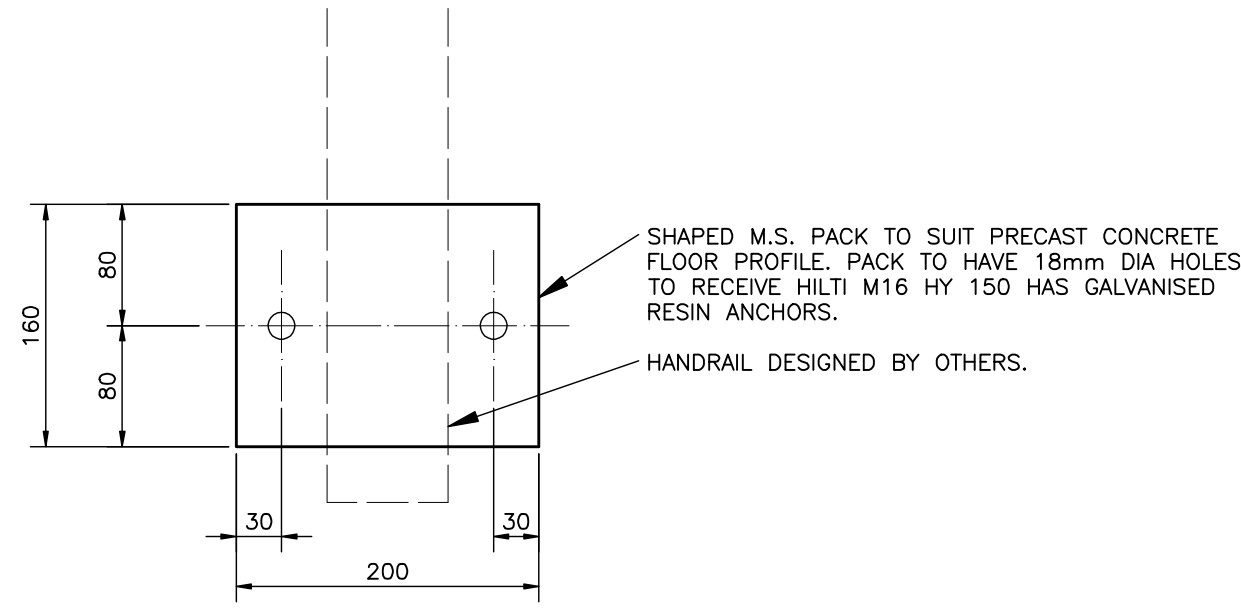

SECTION C-C.
1:5.

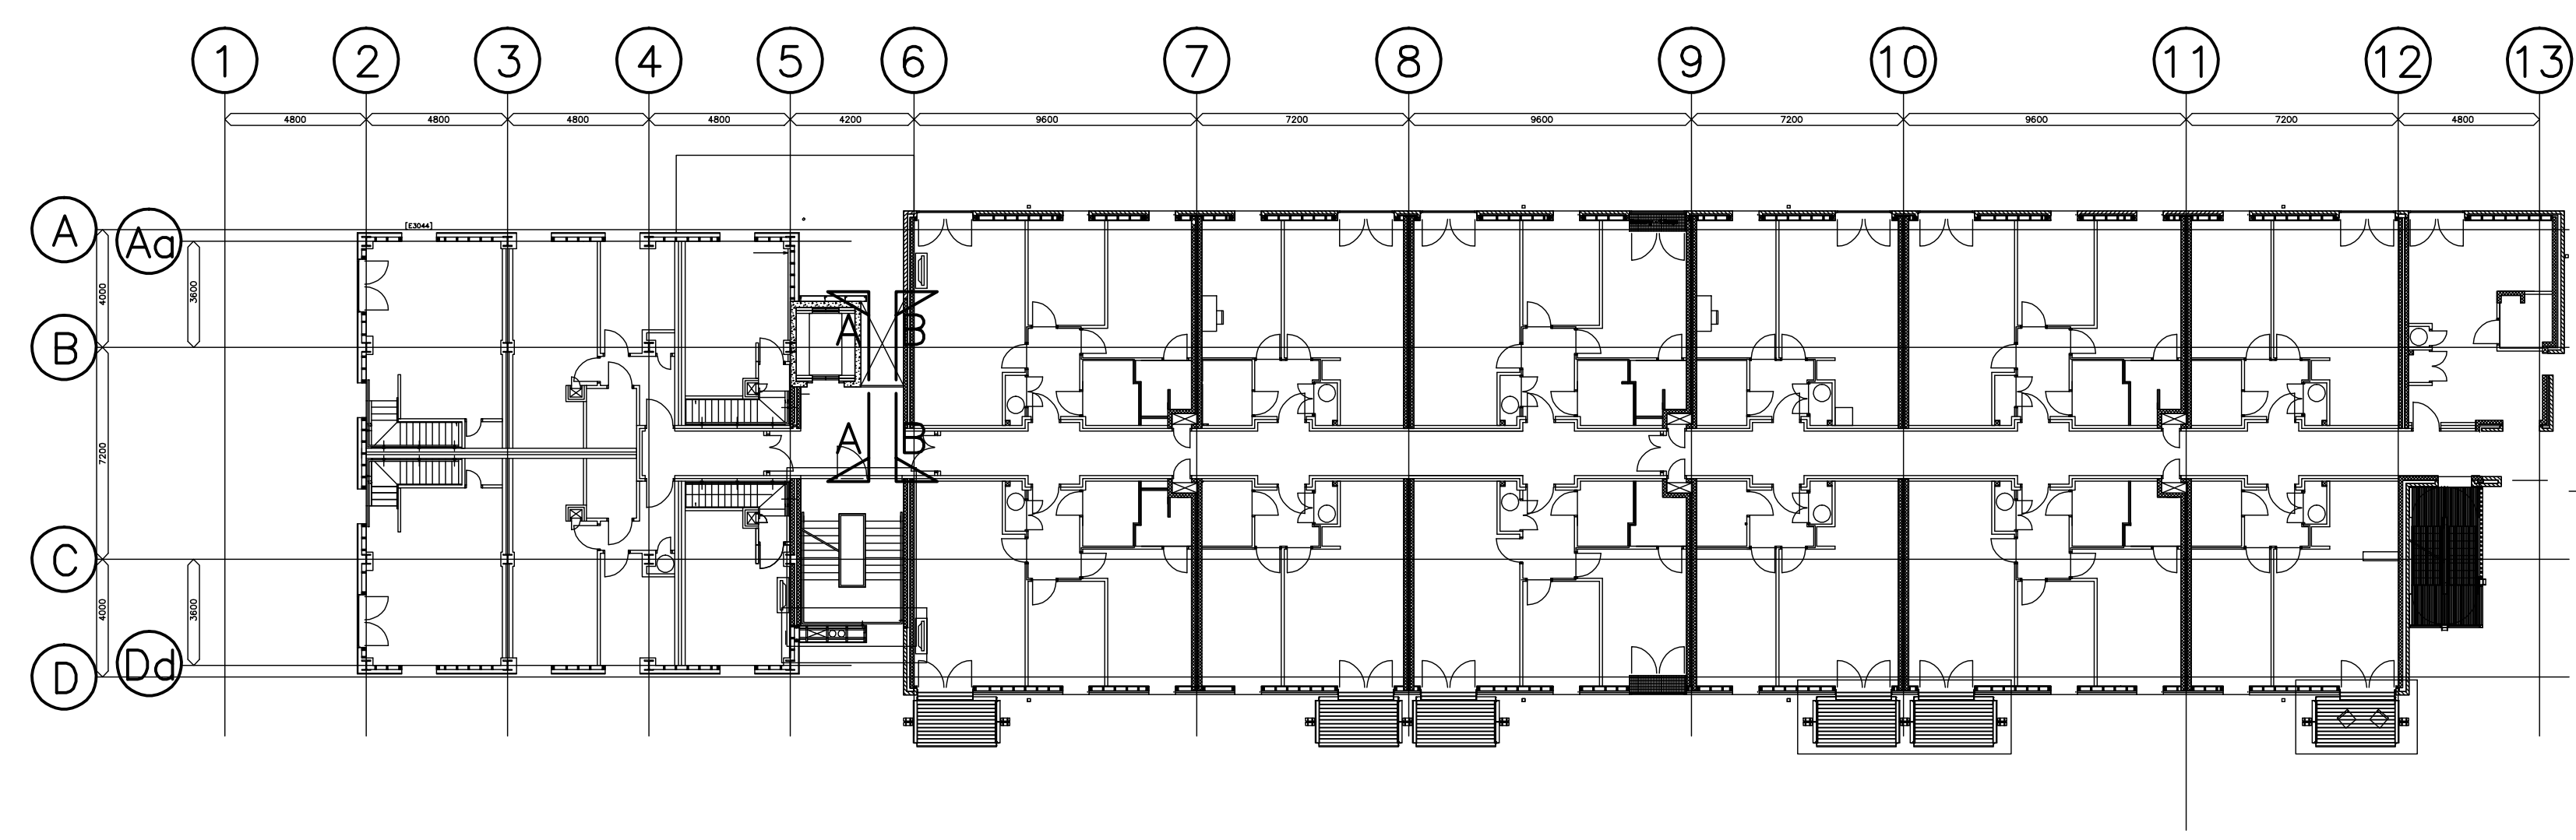

PLAN.
1:200.

IT IS THE CONTRACTORS RESPONSIBILITY TO CHECK ALL
SETTING OUT DIMENSIONS AND REPORT ANY DISCREPANCY
TO THE STRUCTURAL ENGINEER IMMEDIATELY.

NOTES.

MK	REVISIONS	BY	DATE	CHK
----	-----------	----	------	-----

STATUS:—

AS-BUILT


DRAWN BY_ CM WAGSTAFF_ _ _ _ DATE_ 05.03.08 _
CHECKED BY_ _ _ _ _ DATE_ _ _ _ _
PROJECT ENGINEER_ _ _ _ _ DATE_ _ _ _ _

CLIENT.

CTP S JAMES

ARCHITECT.
FaulknerBrowns

CONTRACT
WAKEFIELD WATERFRONT
BUILDING 20

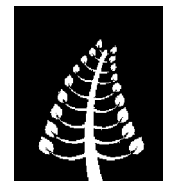

SEJC Consulting Engineers
Consulting Structural & Civil Engineers

Sanderson House, Station Road, Horsforth, Leeds LS18 5NT
Telephone 0113 2590090 Fax 0113 2599840

DRAWING TITLE
HANDRAIL FIXING DETAILS
DETAILS

SCALES 1:200. 1:10.

CONTRACT No	DRG No			
501180C	20-014			