

- NOTES.
- ALL CONCRETE TO BE C40 IN ACCORDANCE WITH SEJC. STANDARD SPECIFICATION FOR CONCRETE. WALL EXTENSION, BETWEEN GRIDS 8 & 9, TO HAVE A MODIFIED C40 MIX - REFER TO SECTION E-E AND 6-6 FOR DETAILS.
 - ALL REINFORCEMENT TO BE HIGH YIELD TYPE B500A, B500B OR B500C RIBBED BARS TO BS4449:2005.
 - BENDING AND SCHEDULING OF REINFORCEMENT TO BE IN ACCORDANCE WITH BS 8666 : 2005
 - 40mm. MINIMUM COVER TO ALL REINFORCEMENT
 -
 - THIS DRAWING TO BE READ IN CONJUNCTION WITH RELEVANT ARCHITECTS DRAWINGS & SEJC DRAWING No's 501180C/20-001, 008 & 009

NB. MINIMUM EDGE DISTANCE, TO CHEMICAL ANCHOR BARS, FROM THE EDGES/CORNERS OF EXISTING CONCRETE FOUNDATIONS/WALLS, TO BE 150mm.

MK	REVISIONS	BY	DATE	CHK


STATUS:-
AS-BUILT

DRAWN BY: SH. DATE: APR. '08.
CHECKED BY: DATE:
PROJECT ENGINEER: DATE:

CLIENT.
CTP & JAMES

ARCHITECT.
FaulknerBrowns

CONTRACT
WAKEFIELD WATERFRONT BUILDING 20

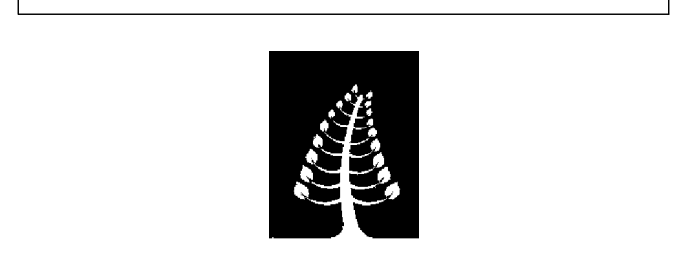

SEJC Consulting Engineers
Consulting Structural & Civil Engineers

Sanderson House, Station Road, Horforth, Leeds LS18 5NT
Telephone 0113 2560090 Fax 0113 2560640

DRAWING TITLE
GA. & RC. DETAILS TO BALCONY FOUNDATIONS

SCALES	1:100. 1:25
CONTRACT No	501180C
DRG No	20-016