

AS-BUILT


CLIENT.

ARCHITECT.

FaulknerBrowns

CONTRACT

WAKEFIELD WATERFRONT
BUILDING 20

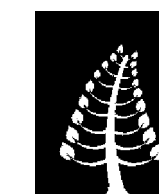

SEJC Consulting Engineers
Consulting Structural & Civil Engineers

Sanderson House, Station Road, Horsforth, Leeds LS18 5NT
Telephone 0113 2590090 Fax 0113 2586640

DRAWING TITLE

ROOF SHEETING HOLDING DOWN DETAILS

SCALES 1:200. 1:5.

CONTRACT No

501180C

DRG No	
--------	--

20-017