


NOTES			
STEELWORK NOTES:			
1. ALL STEELWORK TO BE S275 TO BS EN10025 UNLESS NOTED OTHERWISE			
2. STEELWORK TO BE DESIGNED, FABRICATED AND ERECTED IN ACCORDANCE WITH SEJC CONSULTING ENGINEERS SPECIFICATION			
3. THIS DRAWING TO BE READ IN CONJUNCTION WITH ALL RELEVANT ARCHITECTS AND SEJC CONSULTING ENGINEERS DRAWINGS			
4. WITH THE EXCEPTION OF COLD ROLLED SECTIONS, ALL STEELWORK TO BE SHOT BLAST CLEANED TO SWEDISH STANDARD S.A. 2 1/2 AND PAINTED ONE COAT HIGH BUILD ZINC PHOSPHATE PRIMER TO D.F.T. OF 75 MICRONS. ALL DAMAGED AREAS OF COATING TO BE CLEANED AND TOUCH-UP PAINTED AFTER ERECTION			
5. STEELWORK IN MASONRY CAVITIES TO BE GIVEN 2 COATS OF BITUMEN BASED PAINT BY THE MAIN CONTRACTOR AFTER ERECTION UNLESS NOTED OTHERWISE			
6. ALL CONNECTIONS TO HAVE A MINIMUM OF 2No. M20 BOLTS GRADE 8.8			
7. ALL BASEPLATES TO HAVE MINIMUM 4No. HOLDING DOWN BOLTS			
8. THE STEELWORK CONTRACTOR SHALL INCLUDE FOR ALL TEMPORARY PROPS AND SUPPORTS TO ENSURE TOTAL STABILITY TO THE STRUCTURE AT ALL TIMES			
9. THE STEELWORK FABRICATOR WILL BE RESPONSIBLE FOR TAKING ALL NECESSARY SITE DIMENSIONS FOR FABRICATION PURPOSES			
10. THE STEELWORK FABRICATOR WILL BE RESPONSIBLE FOR THE DESIGN OF ALL STEELWORK CONNECTIONS. ALL DRAWINGS AND CALCULATIONS SHALL BE SUBMITTED TO THE STRUCTURAL ENGINEER FOR COMMENTS PRIOR TO FABRICATION OF THE STEELWORK			
11. STEELWORK BELOW GROUND FLOOR LEVEL TO BE CLEANED TO SPECIFICATION, UNPAINTED AND CASED IN MINIMUM 100mm THICK CONCRETE UNO			
12. FOR POSITIONS AND DETAILS OF HOLDING DOWN BOLTS REFER TO THE STEELWORK CONTRACTORS DRAWINGS			
13. THE STEELWORK CONTRACTOR WILL DESIGN, SUPPLY, FABRICATE AND ERECT IN ACCORDANCE WITH THE CURRENT CODES OF PRACTICE			
14. INCLUDE FOR ALL TEMPORARY AND PERMANENT BRACINGS AND ALL NECESSARY PROPS AND SUPPORTS TO ENSURE TOTAL STABILITY TO THE STRUCTURE AT ALL TIMES			
MK REVISIONS		BY	DATE
			CHK

STATUS:— AS BUILT	
DRAWN BY — S.H.	DATE 26/2/07
CHECKED BY — J.L.	DATE 26/2/07
PROJECT ENGINEER —	DATE —

CLIENT.

ARCHITECT.

CONTRACT
WAKEFIELD WATERFRONT PHASE 1, BUILDING 20

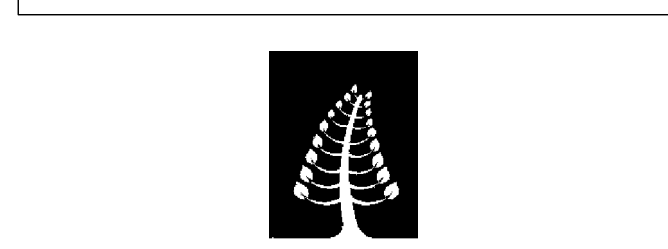

SEJC Consulting Engineers
Consulting Structural & Civil Engineers

Sanderson House, Station Road, Horforth, Leeds LS18 5NT
Telephone 0113 2590090 Fax 0113 2598640

DRAWING TITLE	
LEVEL 1/1A STEELWORK LAYOUT	
SCALES 1:125 1:25 (@A1)	
CONTRACT No	DRG No
501180C	20-201

