

- NOTES
- STEELWORK NOTES:
1. ALL STEELWORK TO BE S275 TO BSEN10025 UNLESS NOTED OTHERWISE
 2. STEELWORK TO BE DESIGNED, FABRICATED AND ERECTED IN ACCORDANCE WITH SEJC CONSULTING ENGINEERS SPECIFICATION
 3. THIS DRAWING TO BE READ IN CONJUNCTION WITH ALL RELEVANT ARCHITECTS AND SEJC CONSULTING ENGINEERS DRAWINGS
 4. ALL STEELWORK TO BE GALVANIZED
 5. STEELWORK IN MASONRY CAVITIES TO BE GIVEN 2 COATS OF BITUMEN BASED PAINT BY THE MAIN CONTRACTOR AFTER ERECTION UNLESS NOTED OTHERWISE
 6. ALL CONNECTIONS TO HAVE A MINIMUM OF 2No M20 BOLTS GRADE 8.8
 7. ALL BASEPLATES TO HAVE MINIMUM 4No. HOLDING DOWN BOLTS
 8. THE STEELWORK CONTRACTOR SHALL INCLUDE FOR ALL TEMPORARY AND PERMANENT BRACINGS AND ALL NECESSARY TEMPORARY PROPS AND SUPPORTS TO ENSURE TOTAL STABILITY TO THE STRUCTURE AT ALL TIMES
 9. THE STEELWORK FABRICATOR WILL BE RESPONSIBLE FOR TAKING ALL NECESSARY SITE DIMENSIONS FOR FABRICATION PURPOSES.
 10. THE STEELWORK FABRICATOR WILL BE RESPONSIBLE FOR THE DESIGN OF ALL STEELWORK CONNECTIONS. ALL DRAWINGS AND CALCULATIONS SHALL BE SUBMITTED TO THE STRUCTURAL ENGINEER FOR COMMENTS PRIOR TO FABRICATION OF THE STEELWORK
 11. STEELWORK BELOW GROUND FLOOR LEVEL TO BE CLEANED TO SPECIFICATION, UNPAINTED AND CAGED IN MINIMUM 100mm THICK CONCRETE UNO
 12. FOR POSITIONS AND DETAILS OF HOLDING DOWN BOLTS REFER TO THE STEELWORK CONTRACTORS DRAWINGS
 13. THE STEELWORK CONTRACTOR WILL DESIGN, SUPPLY, FABRICATE AND ERECT IN ACCORDANCE WITH THE CURRENT CODES OF PRACTICE
 14. INCLUDE FOR ALL TEMPORARY AND PERMANENT BRACINGS AND ALL NECESSARY PROPS AND SUPPORTS TO ENSURE TOTAL STABILITY TO THE STRUCTURE AT ALL TIMES


REVISIONS	BY	DATE	CHK
MK			

STATUS:— AS BUILT	
DRAWN BY — A.K.	DATE APRIL 2008
CHECKED BY —	DATE —
PROJECT ENGINEER —	DATE —

CLIENT.
CTP & JAMES

ARCHITECT.
FaulknerBrowns

CONTRACT
WAKEFIELD WATERFRONT PHASE 1, BUILDING 20

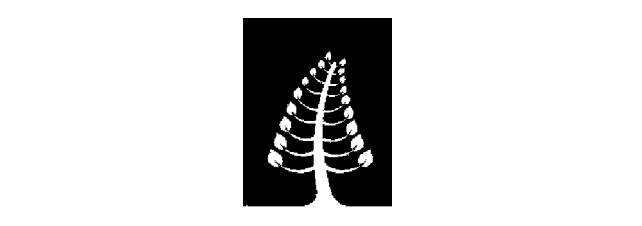

SEJC Consulting Engineers
Consulting Structural & Civil Engineers

Sanderson House, Station Road, Horforth, Leeds LS18 5NT
Telephone 0113 2590090 Fax 0113 2596840

DRAWING TITLE	
ESCAPE STAIR	
SCALES 1:25 1:20 1:10 @A1	
CONTRACT No	DRG No
501180C	20—211