


TYPICAL PLAN AT UPPER BEAM LOCATIONS (4No. BEAMS REQ'D THUS)

TYPICAL PLAN AT LOWER BEAM LEVEL (1No. BEAM REQ'D THUS)

1:50


1:50

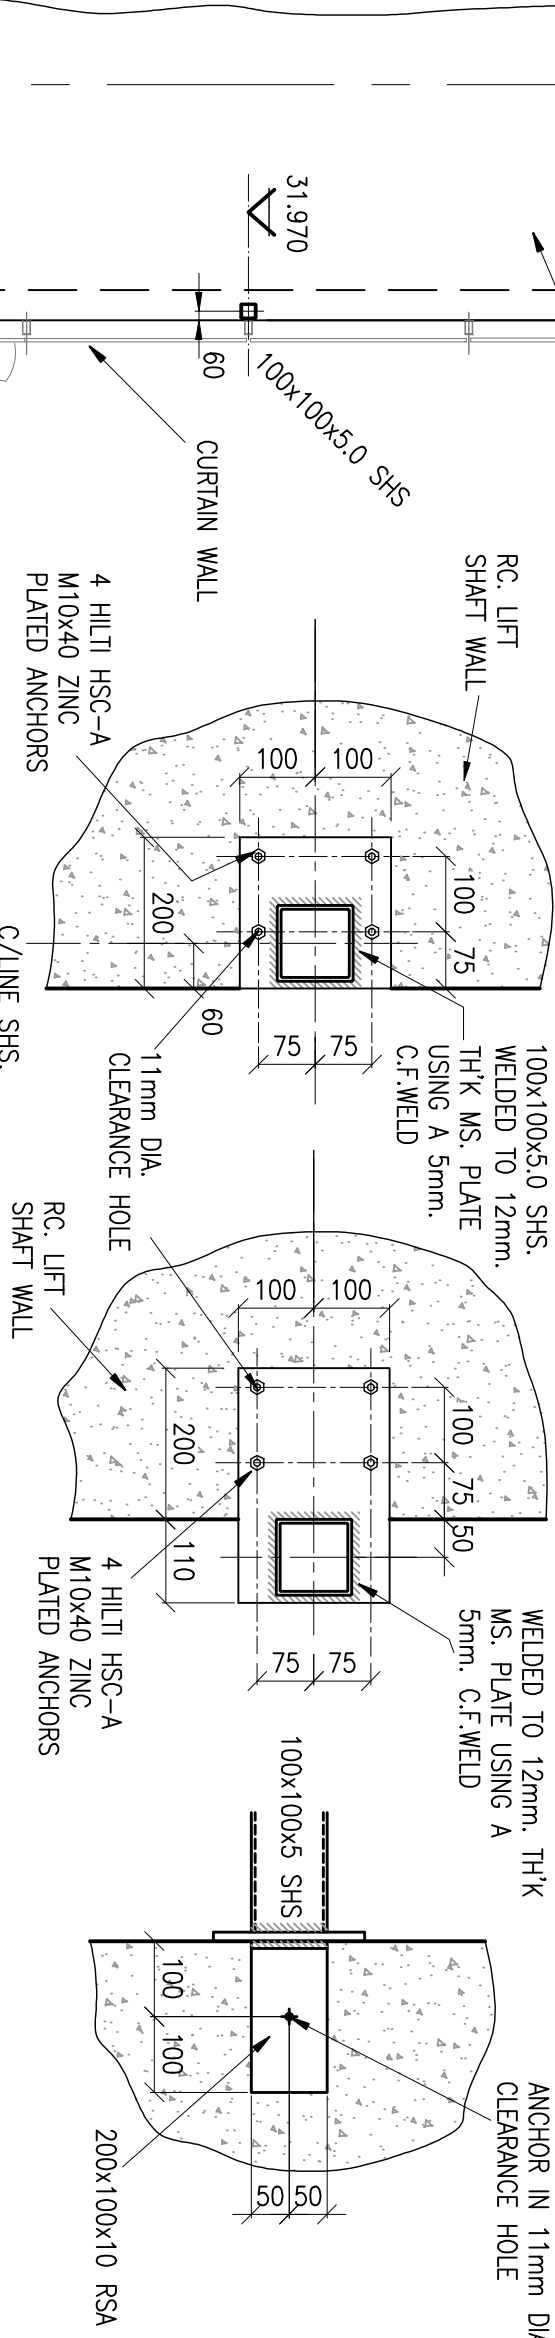

1:10

1:10

1:10

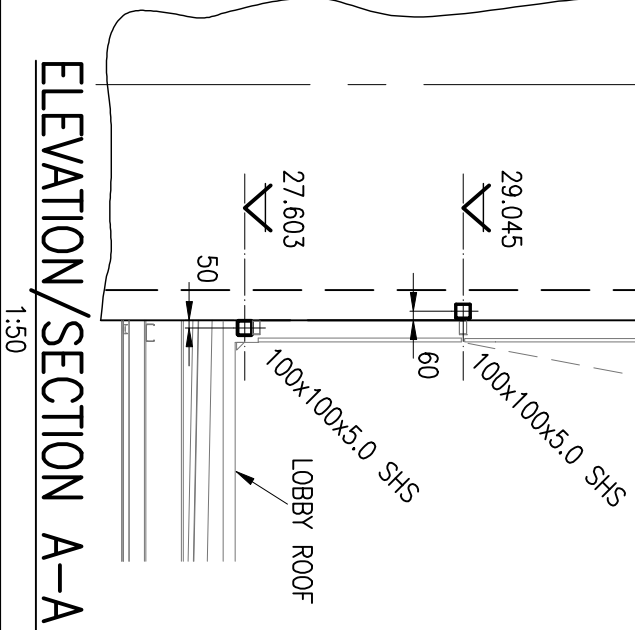

1:50

1:10

1:10

1:10

DRAWING TITLE			
CURTAIN WALL SUPPORTS BETWEEN LIFT SHAFT & GRIDLINE 6			
SCALES 1:50, 1:10 (@ A3)			
CONTRACT No	DRG No		
501180C	20-213		

Sanderson House, Station Road, Horsforth, Leeds LS18 5NT  
Telephone 0113 2590080 Fax 0113 2590840

SEJC Consulting Engineers  
Consulting Structural & Civil Engineers



CONTRACT  
WAKEFIELD WATERFRONT,  
PHASE 1,  
BUILDING 20

ARCHITECT  
FaulknerBrowns

CTP St JAMES

CLIENT.

DRAWN BY SH. DATE DEC.'07  
CHECKED BY - - - - - DATE - - - - -  
PROJECT ENGINEER - - - - - DATE - - - - -

STATUS:-  
AS BUILT