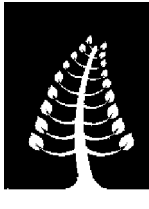


NOTES			
MK	REVISIONS	BY	DATE
		CHK	K
STATUS:— AS BUILT			
DRAWN BY _ A.K.		DATE MARCH 2008	
CHECKED BY _		DATE	
PROJECT ENGINEER _		DATE _	
CLIENT.			
<div style="border: 1px solid black; display: inline-block; padding: 5px;">CTP</div> <div style="border: 1px solid black; display: inline-block; padding: 5px;">S JAMES</div>			
ARCHITECT.			
FaulknerBrowns			
CONTRACT			
WAKEFIELD WATERFRONT PHASE 1, BUILDING 20			
			
SEJC Consulting Engineers Consulting Structural & Civil Engineers			
Sanderson House, Station Road, Horsforth, Leeds LS18 5NT Telephone 0113 2580090 Fax 0113 2588640			
DRAWING TITLE			
BLOCKWORK WALL ON GRIDLINE A BETWEEN GRID 12 AND 13			
SCALES 1:50 1:10			
CONTRACT No	DRG No		
501180C	20-217		