



SECTION A-A.
1:10.


SECTION B-B.
1:10.

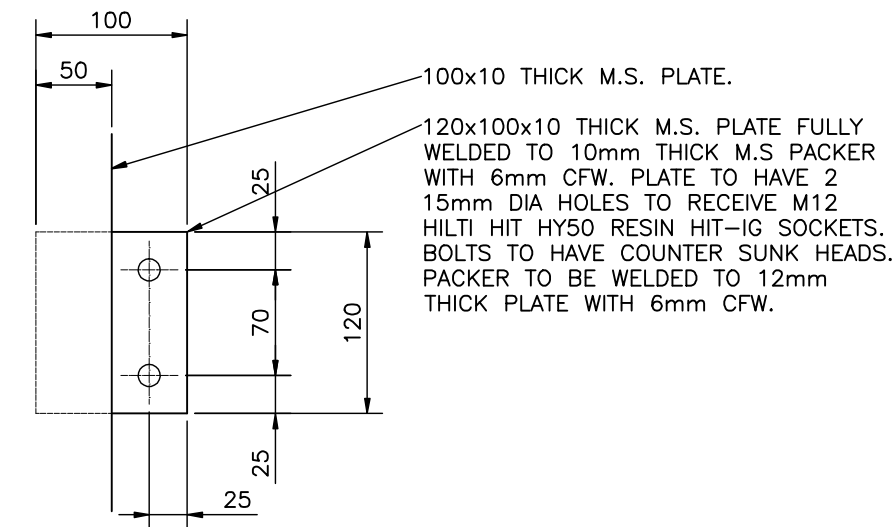


DETAIL 1.
1:5.

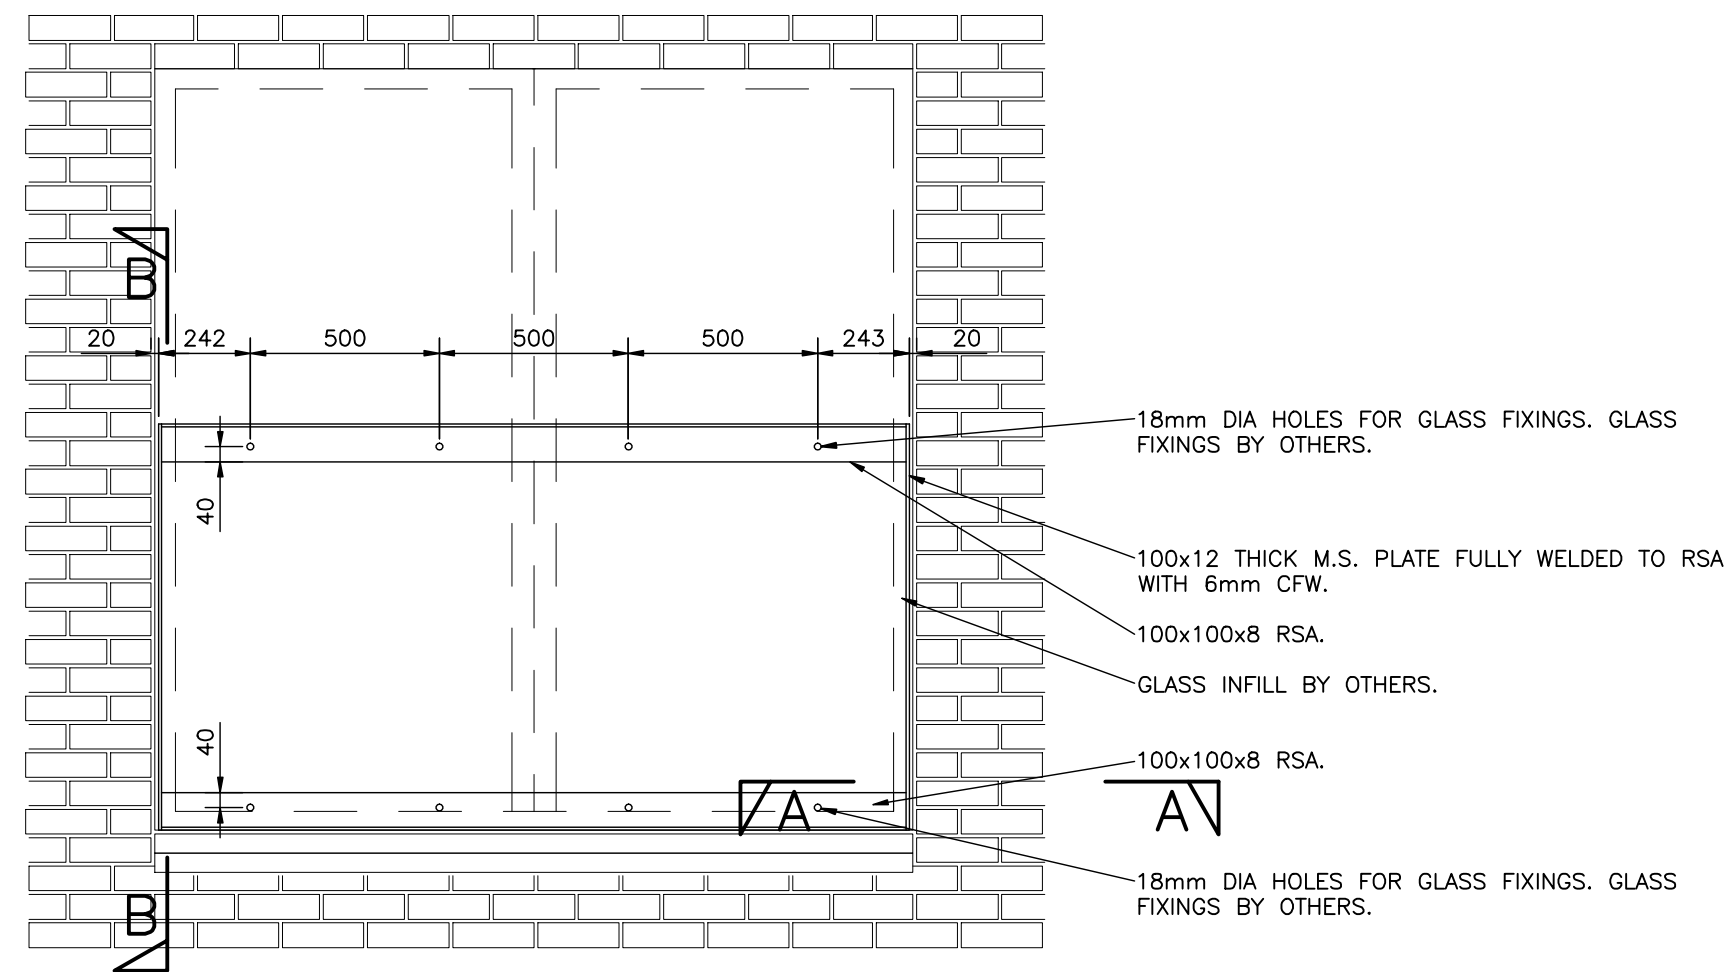


ELEVATION ON 'C'.
1:20.

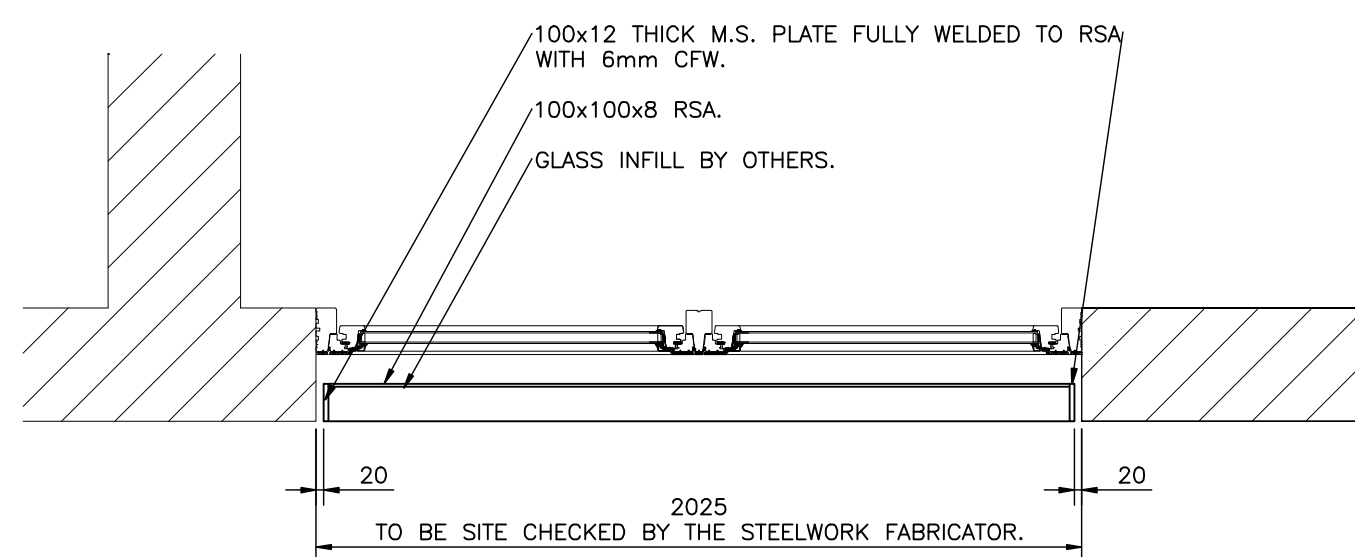


PART PLAN.
1:20.

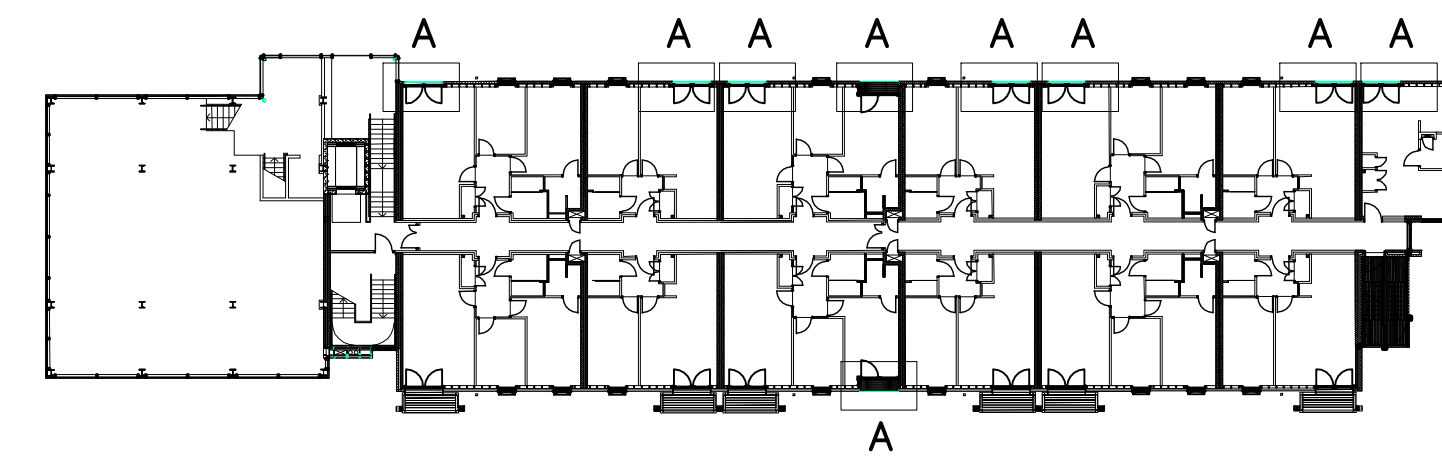


LEVEL 1A KEY PLAN.

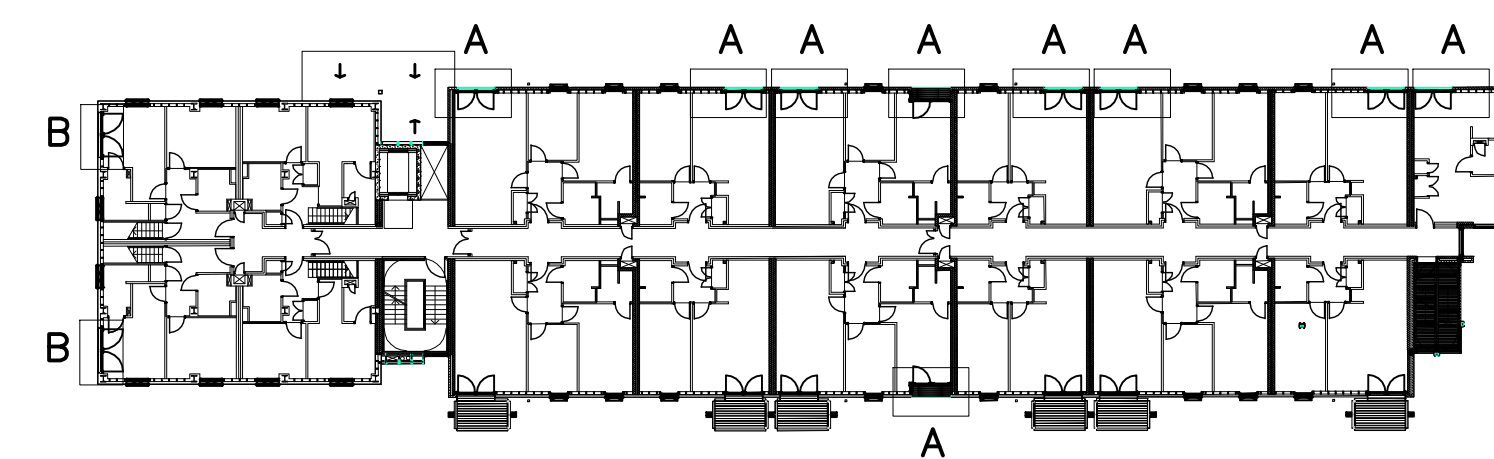

LEVEL 2 KEY PLAN.

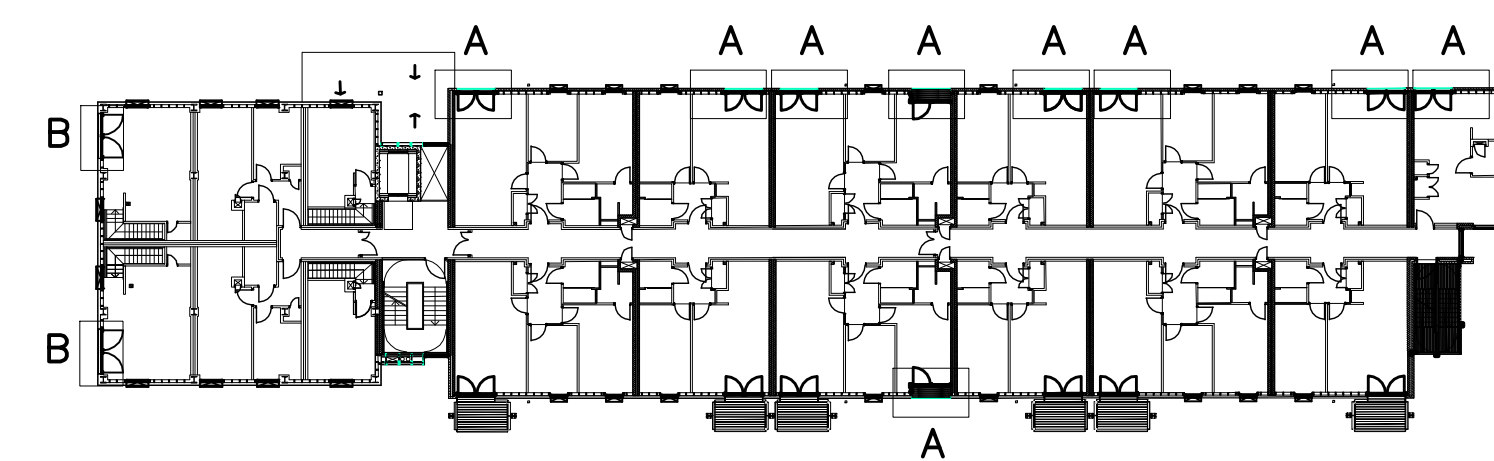

LEVEL 3 KEY PLAN.

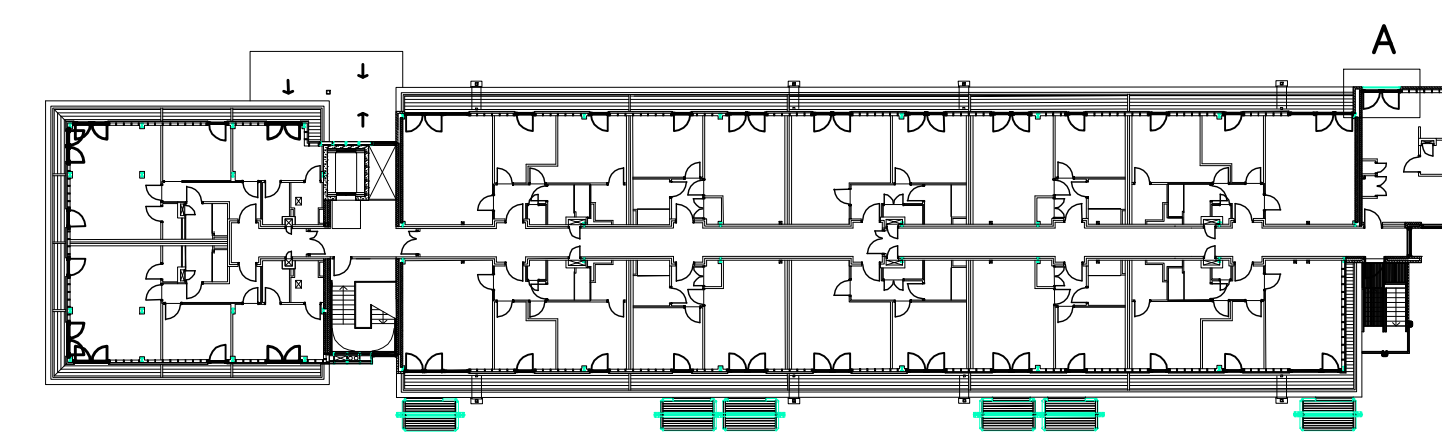

LEVEL 4 KEY PLAN.

IT IS THE CONTRACTORS RESPONSIBILITY TO CHECK ALL SETTING OUT DIMENSIONS AND REPORT ANY DISCREPANCY TO THE STRUCTURAL ENGINEER IMMEDIATELY.

NOTES.

STEELWORK NOTES.

- 1 ALL STEELWORK TO BE GRADE 43 TO BS4360 UNLESS NOTED OTHERWISE.
- 2 STEELWORK TO BE DESIGNED, FABRICATED AND ERECTED IN ACCORDANCE WITH SEJC CONSULTING ENGINEERS SPECIFICATION.
- 3 THIS DRAWING TO BE READ IN CONJUNCTION WITH ALL RELEVANT ARCHITECTS AND SEJC CONSULTING ENGINEERS DRAWINGS.
- 4 THE STEELWORK FABRICATOR WILL BE RESPONSIBLE FOR TAKING ALL NECESSARY SITE DIMENSIONS FOR FABRICATION PURPOSES.
- 5 THE STEELWORK CONTRACTOR WILL DESIGN, SUPPLY, FABRICATE AND ERECT IN ACCORDANCE WITH THE CURRENT CODES OF PRACTICE.

MK	REVISIONS	BY	DATE	CHK
----	-----------	----	------	-----

STATUS:—

AS BUILT

DRAWN BY CM WAGSTAFF DATE 08.04.08
CHECKED BY DATE
PROJECT ENGINEER DATE

CLIENT.


CTP & JAMES

ARCHITECT.

FaulknerBrowns

CONTRACT

WAKEFIELD WATERFRONT
BUILDING 18

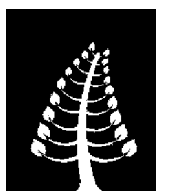

SEJC Consulting Engineers
Consulting Structural & Civil Engineers

Sanderson House, Station Road, Horsforth, Leeds LS18 5NT
Telephone 0113 2580090 Fax 0113 2580640

DRAWING TITLE
JULIET BALCONY TYPE 'A'
G.A. DETAILS

SCALES 1:20, 1:10.

CONTRACT No	DRG No		
501180C	20-222		