




SECTION A-A.
1:5.

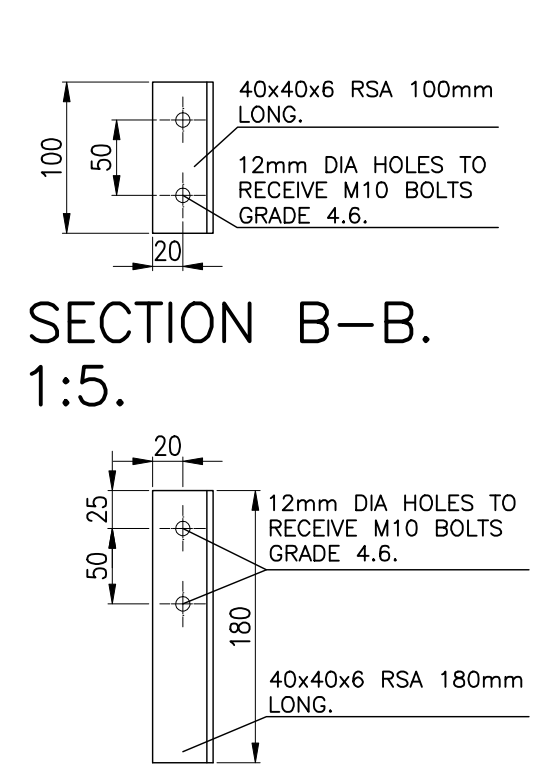


SECTION B-B.
1:5.

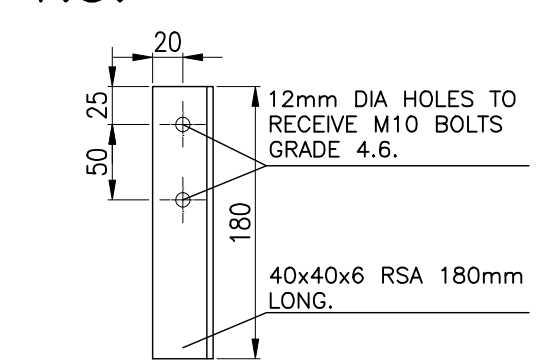

SECTION C-C.
1:5.

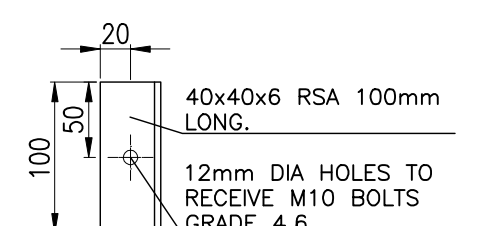


DETAIL 1.
1:5.

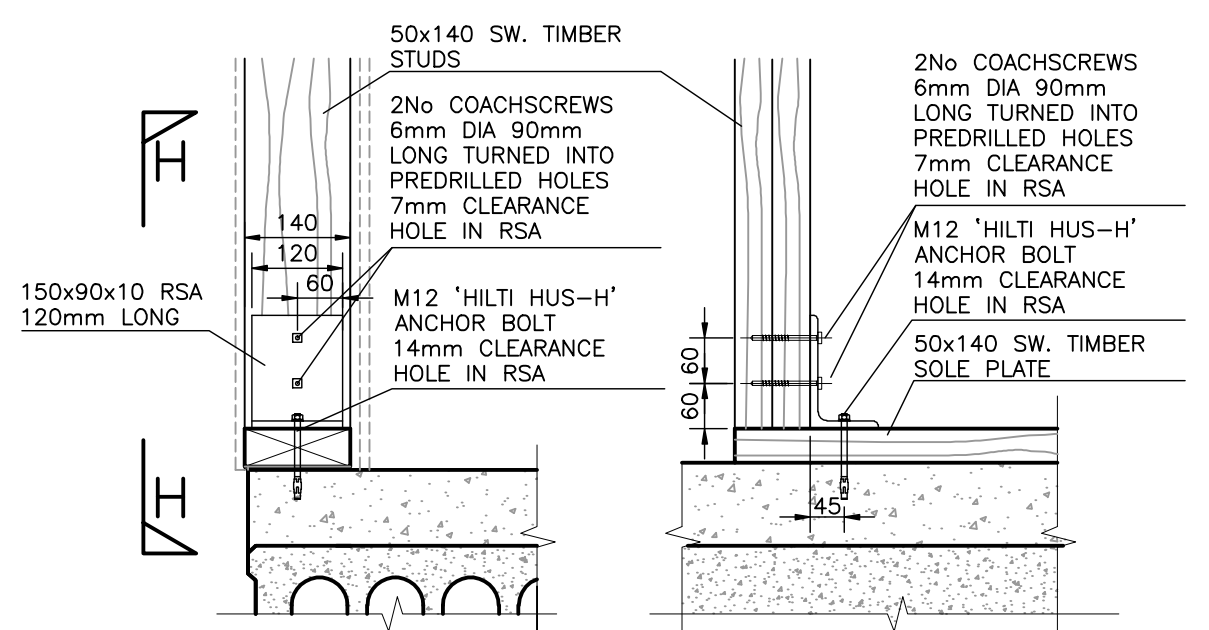

SECTION G-G.
1:10. FIXING TO HEAD PLATE SIMILAR

SECTION H-H.
1:10. FIXING TO HEAD PLATE SIMILAR

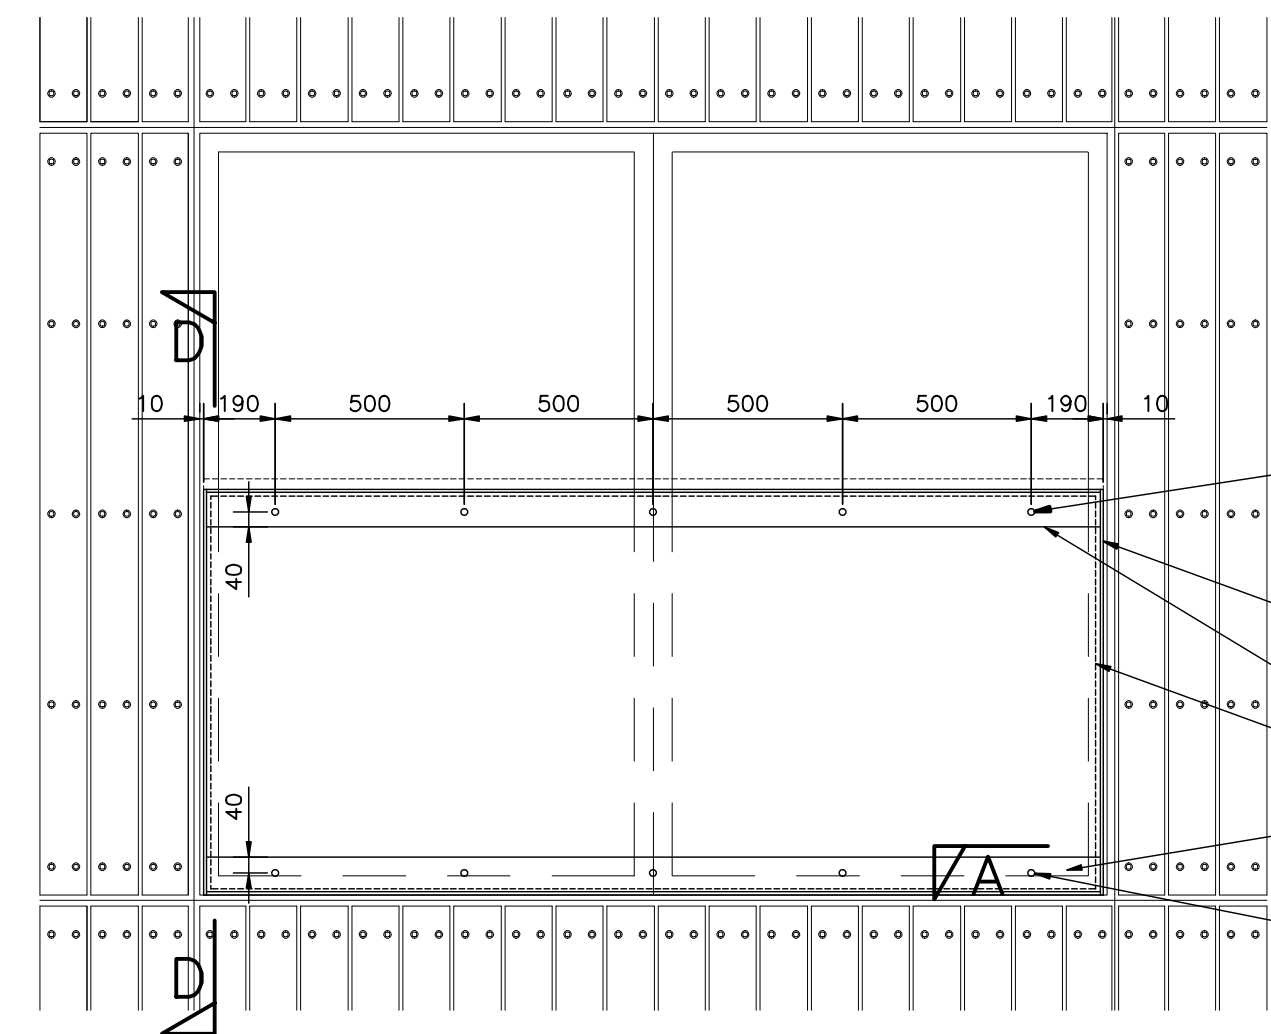


ELEVATION ON 'E'.
1:20.


18mm DIA HOLES FOR GLASS FIXINGS. GLASS FIXINGS BY OTHERS.
100x12 THICK M.S. PLATE FULLY WELDED TO RSA WITH 6mm CFW.
100x100x8 RSA.
GLASS INFILL BY OTHERS.
100x100x8 RSA.
18mm DIA HOLES FOR GLASS FIXINGS. GLASS FIXINGS BY OTHERS.

NOTE.
GLAZING INFILL PANEL FIXED TO STEELWORK IN ACCORDANCE WITH THE MANUFACTURERS DETAILS.


NOTE.
ALL STEELWORK TO BE GALVANISED.

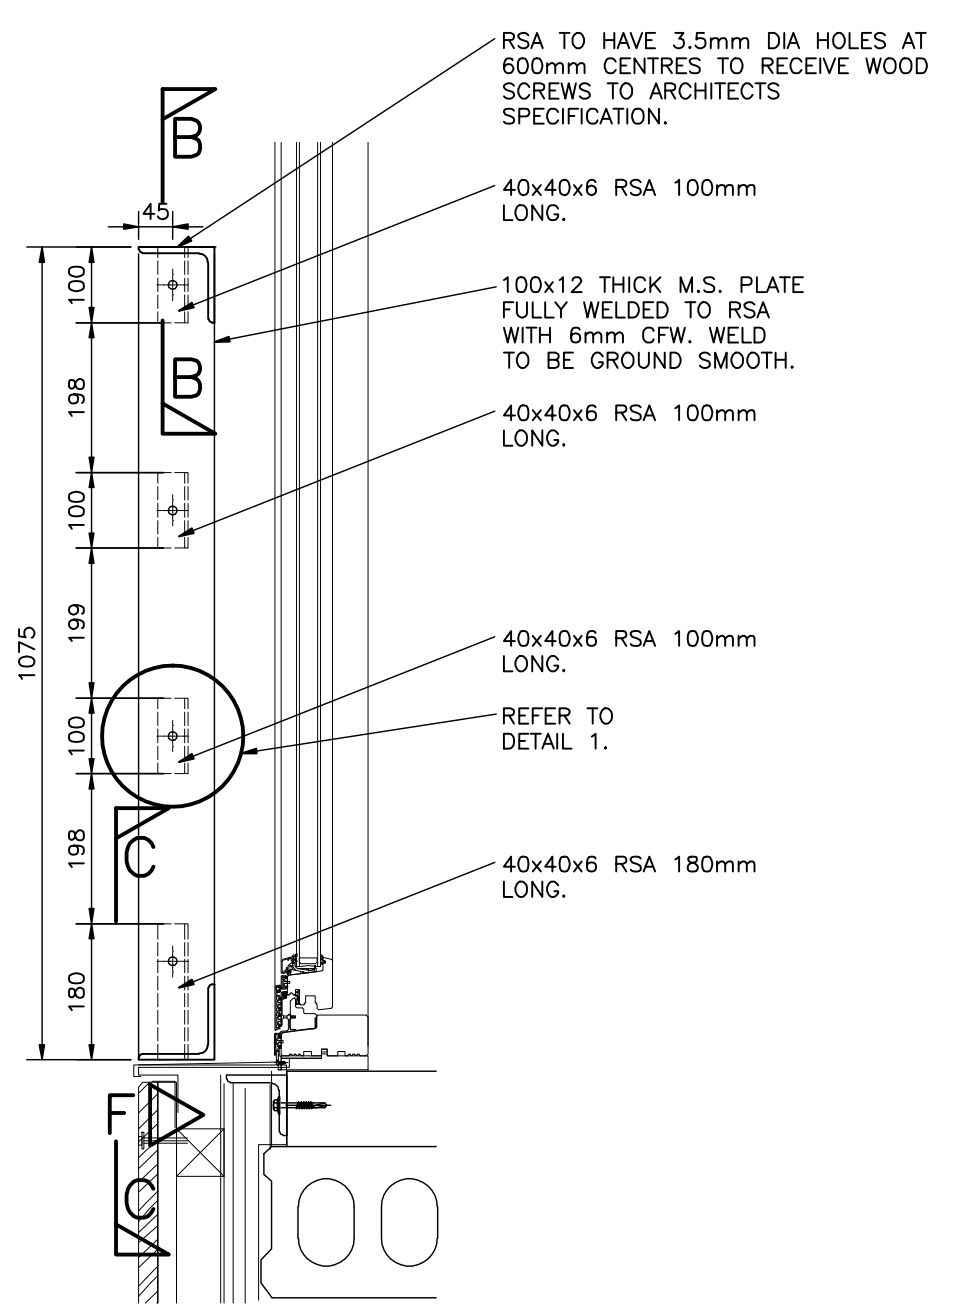


SECTION D-D.
1:10.

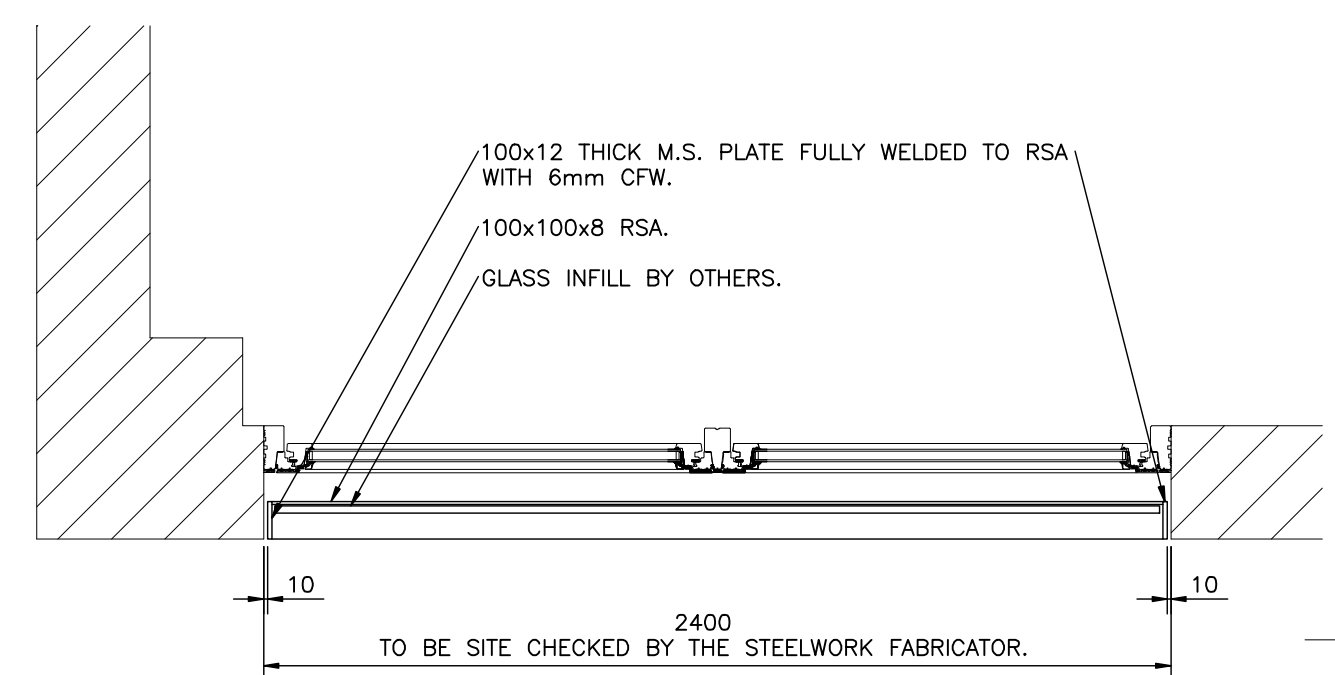


PART PLAN.
1:20.

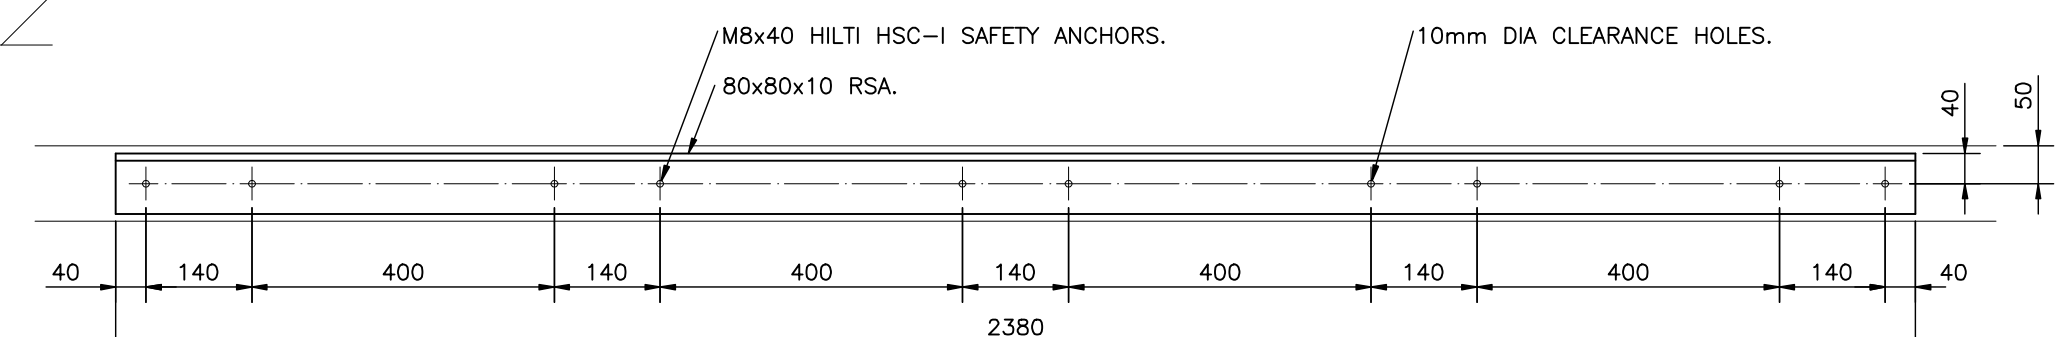


ELEVATION ON 'F'.
1:10.

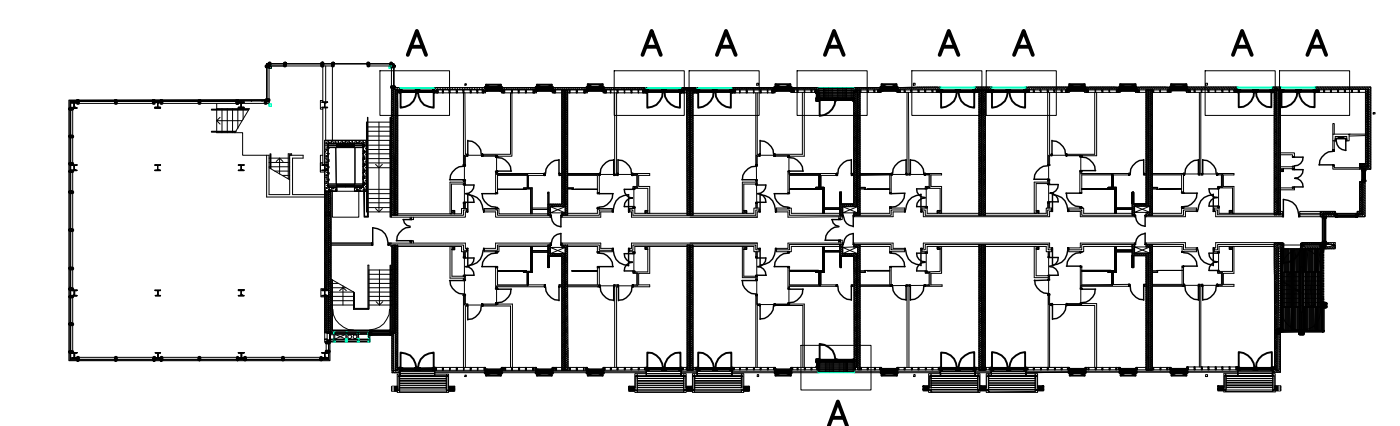


LEVEL 1A KEY PLAN.

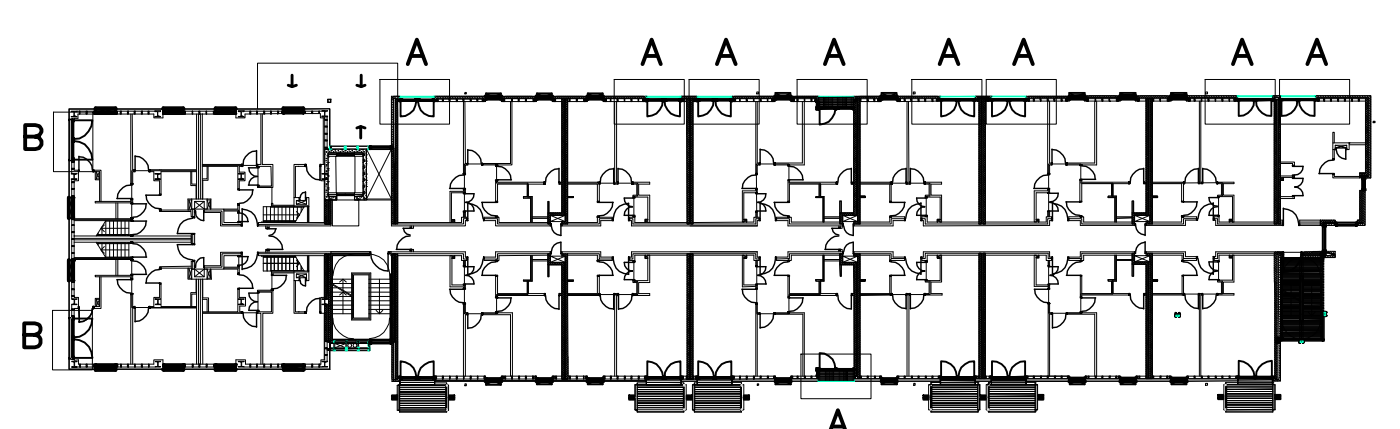

LEVEL 2 KEY PLAN.

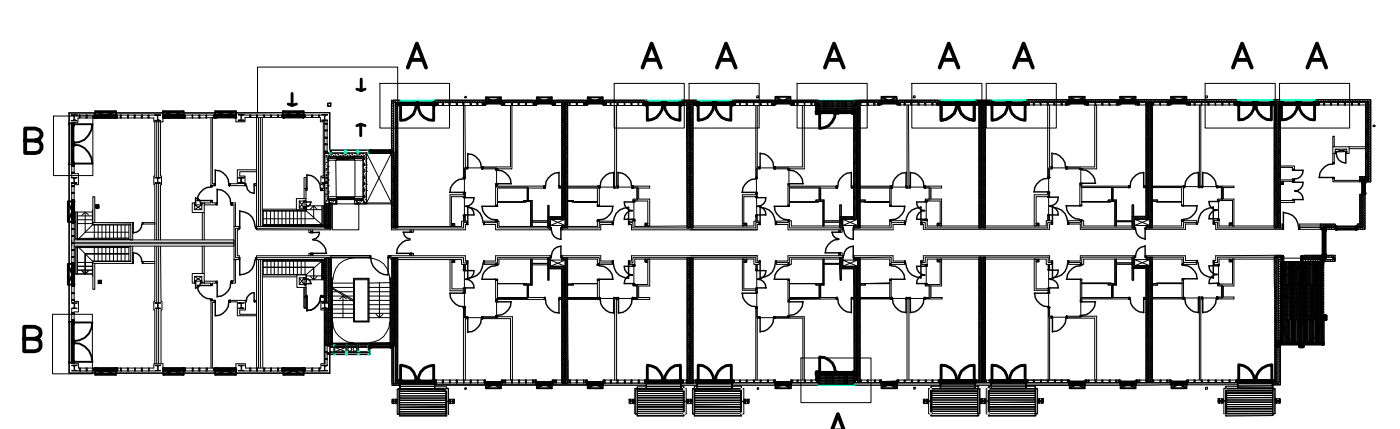

LEVEL 3 KEY PLAN.

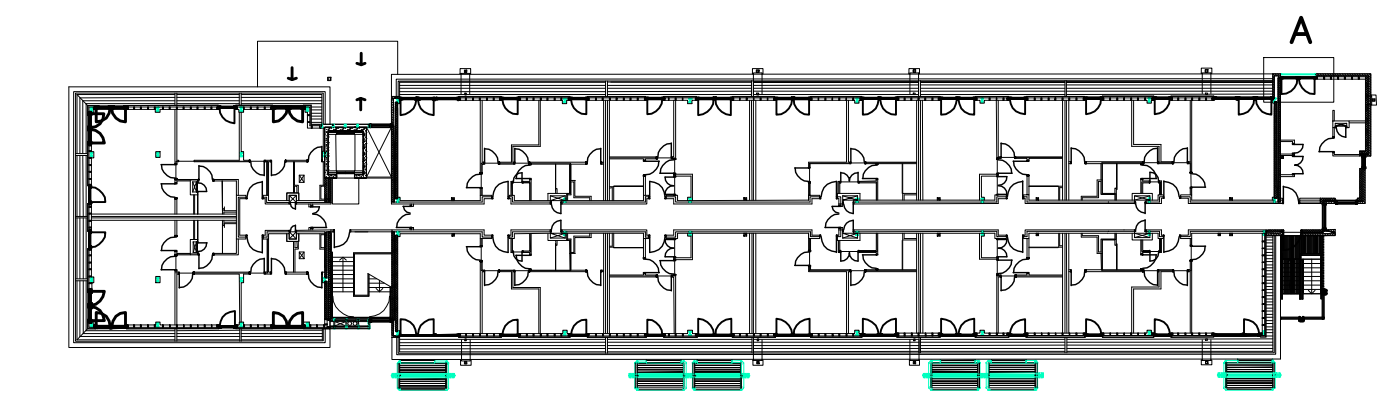

LEVEL 4 KEY PLAN.

IT IS THE CONTRACTORS RESPONSIBILITY TO CHECK ALL SETTING OUT DIMENSIONS AND REPORT ANY DISCREPANCY TO THE STRUCTURAL ENGINEER IMMEDIATELY.

NOTES.

- STEELWORK NOTES.
- 1 ALL STEELWORK TO BE GRADE 43 TO BS4360 UNLESS NOTED OTHERWISE.
 - 2 STEELWORK TO BE DESIGNED, FABRICATED AND ERECTED IN ACCORDANCE WITH SEJC CONSULTING ENGINEERS SPECIFICATION.
 - 3 THIS DRAWING TO BE READ IN CONJUNCTION WITH ALL RELEVANT ARCHITECTS AND SEJC CONSULTING ENGINEERS DRAWINGS.
 - 4 THE STEELWORK FABRICATOR WILL BE RESPONSIBLE FOR TAKING ALL NECESSARY SITE DIMENSIONS FOR FABRICATION PURPOSES.
 - 5 THE STEELWORK CONTRACTOR WILL DESIGN, SUPPLY, FABRICATE AND ERECT IN ACCORDANCE WITH THE CURRENT CODES OF PRACTICE.

MK	REVISIONS	BY	DATE	CHK
----	-----------	----	------	-----

STATUS:--
AS BUILT

DRAWN BY: CM WAGSTAFF. DATE: 08.04.08
CHECKED BY: DATE:
PROJECT ENGINEER: DATE:

CLIENT.
CTP S' JAMES

ARCHITECT.
FaulknerBrowns

CONTRACT
WAKEFIELD WATERFRONT BUILDING 18


SEJC Consulting Engineers
Consulting Structural & Civil Engineers

Sanderson House, Station Road, Horforth, Leeds LS18 5NT
Telephone 0113 2590090 Fax 0113 2599940

DRAWING TITLE
JULIET BALCONY TYPE 'B'
G.A. DETAILS

SCALES 1:20 1:10 @A1

CONTRACT No	DRG No		
501180C	20-223		