
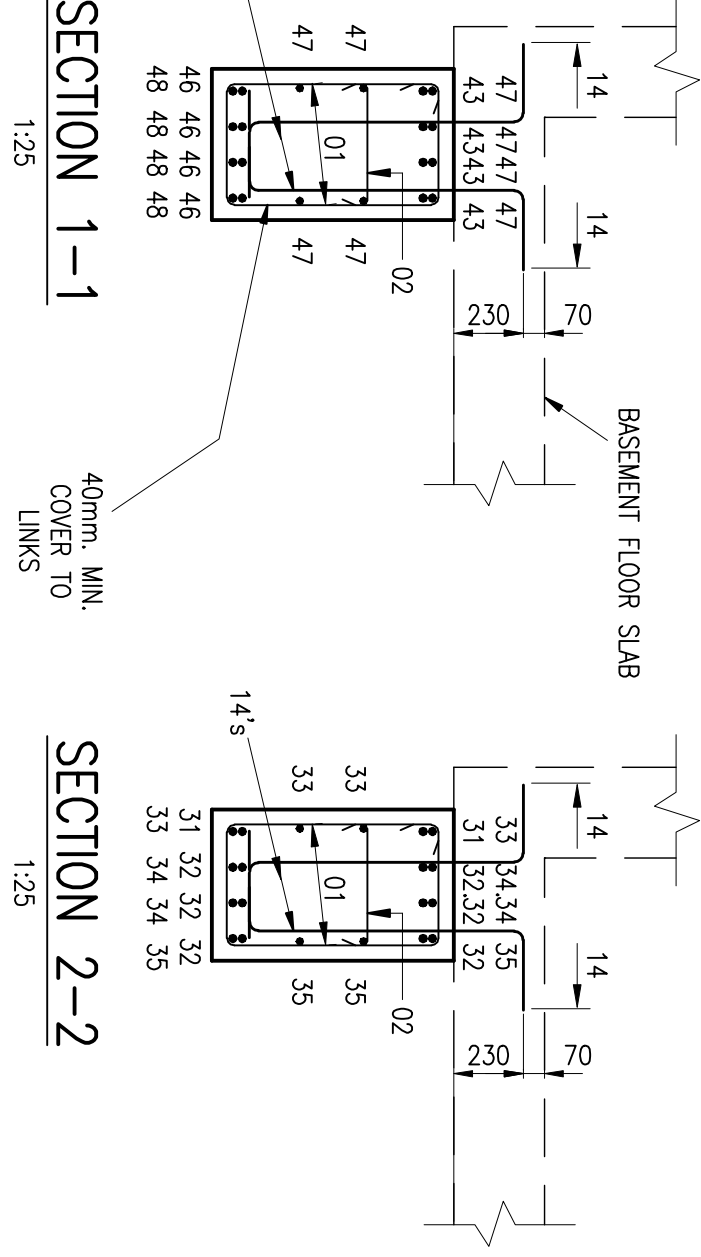


- CONCRETE NOTES
1. ALL MATERIALS AND WORKMANSHIP TO COMPLY WITH S.E.I.C. CONSULTING ENGINEERS STANDARD ALL RELEVANT BRITISH STANDARDS.
 2. THIS DRAWING TO BE READ IN CONJUNCTION WITH ALL RELEVANT ARCHITECTS AND S.E.I.C. DRAWINGS AND SPECIFICATIONS.
 3. ALL REVISIONS TO BE LISTED ON DRAWING SCHEDULE No.4.
 4. CORNER TO BE REINFORCED - 4 DOWN, MINIMUM, TO LINKS.

IT IS THE CONTRACTORS RESPONSIBILITY TO CHECK ALL REVISIONS TO BE LISTED ON DRAWING SCHEDULE No.4 TO THE STRUCTURAL ENGINEER IMMEDIATELY.

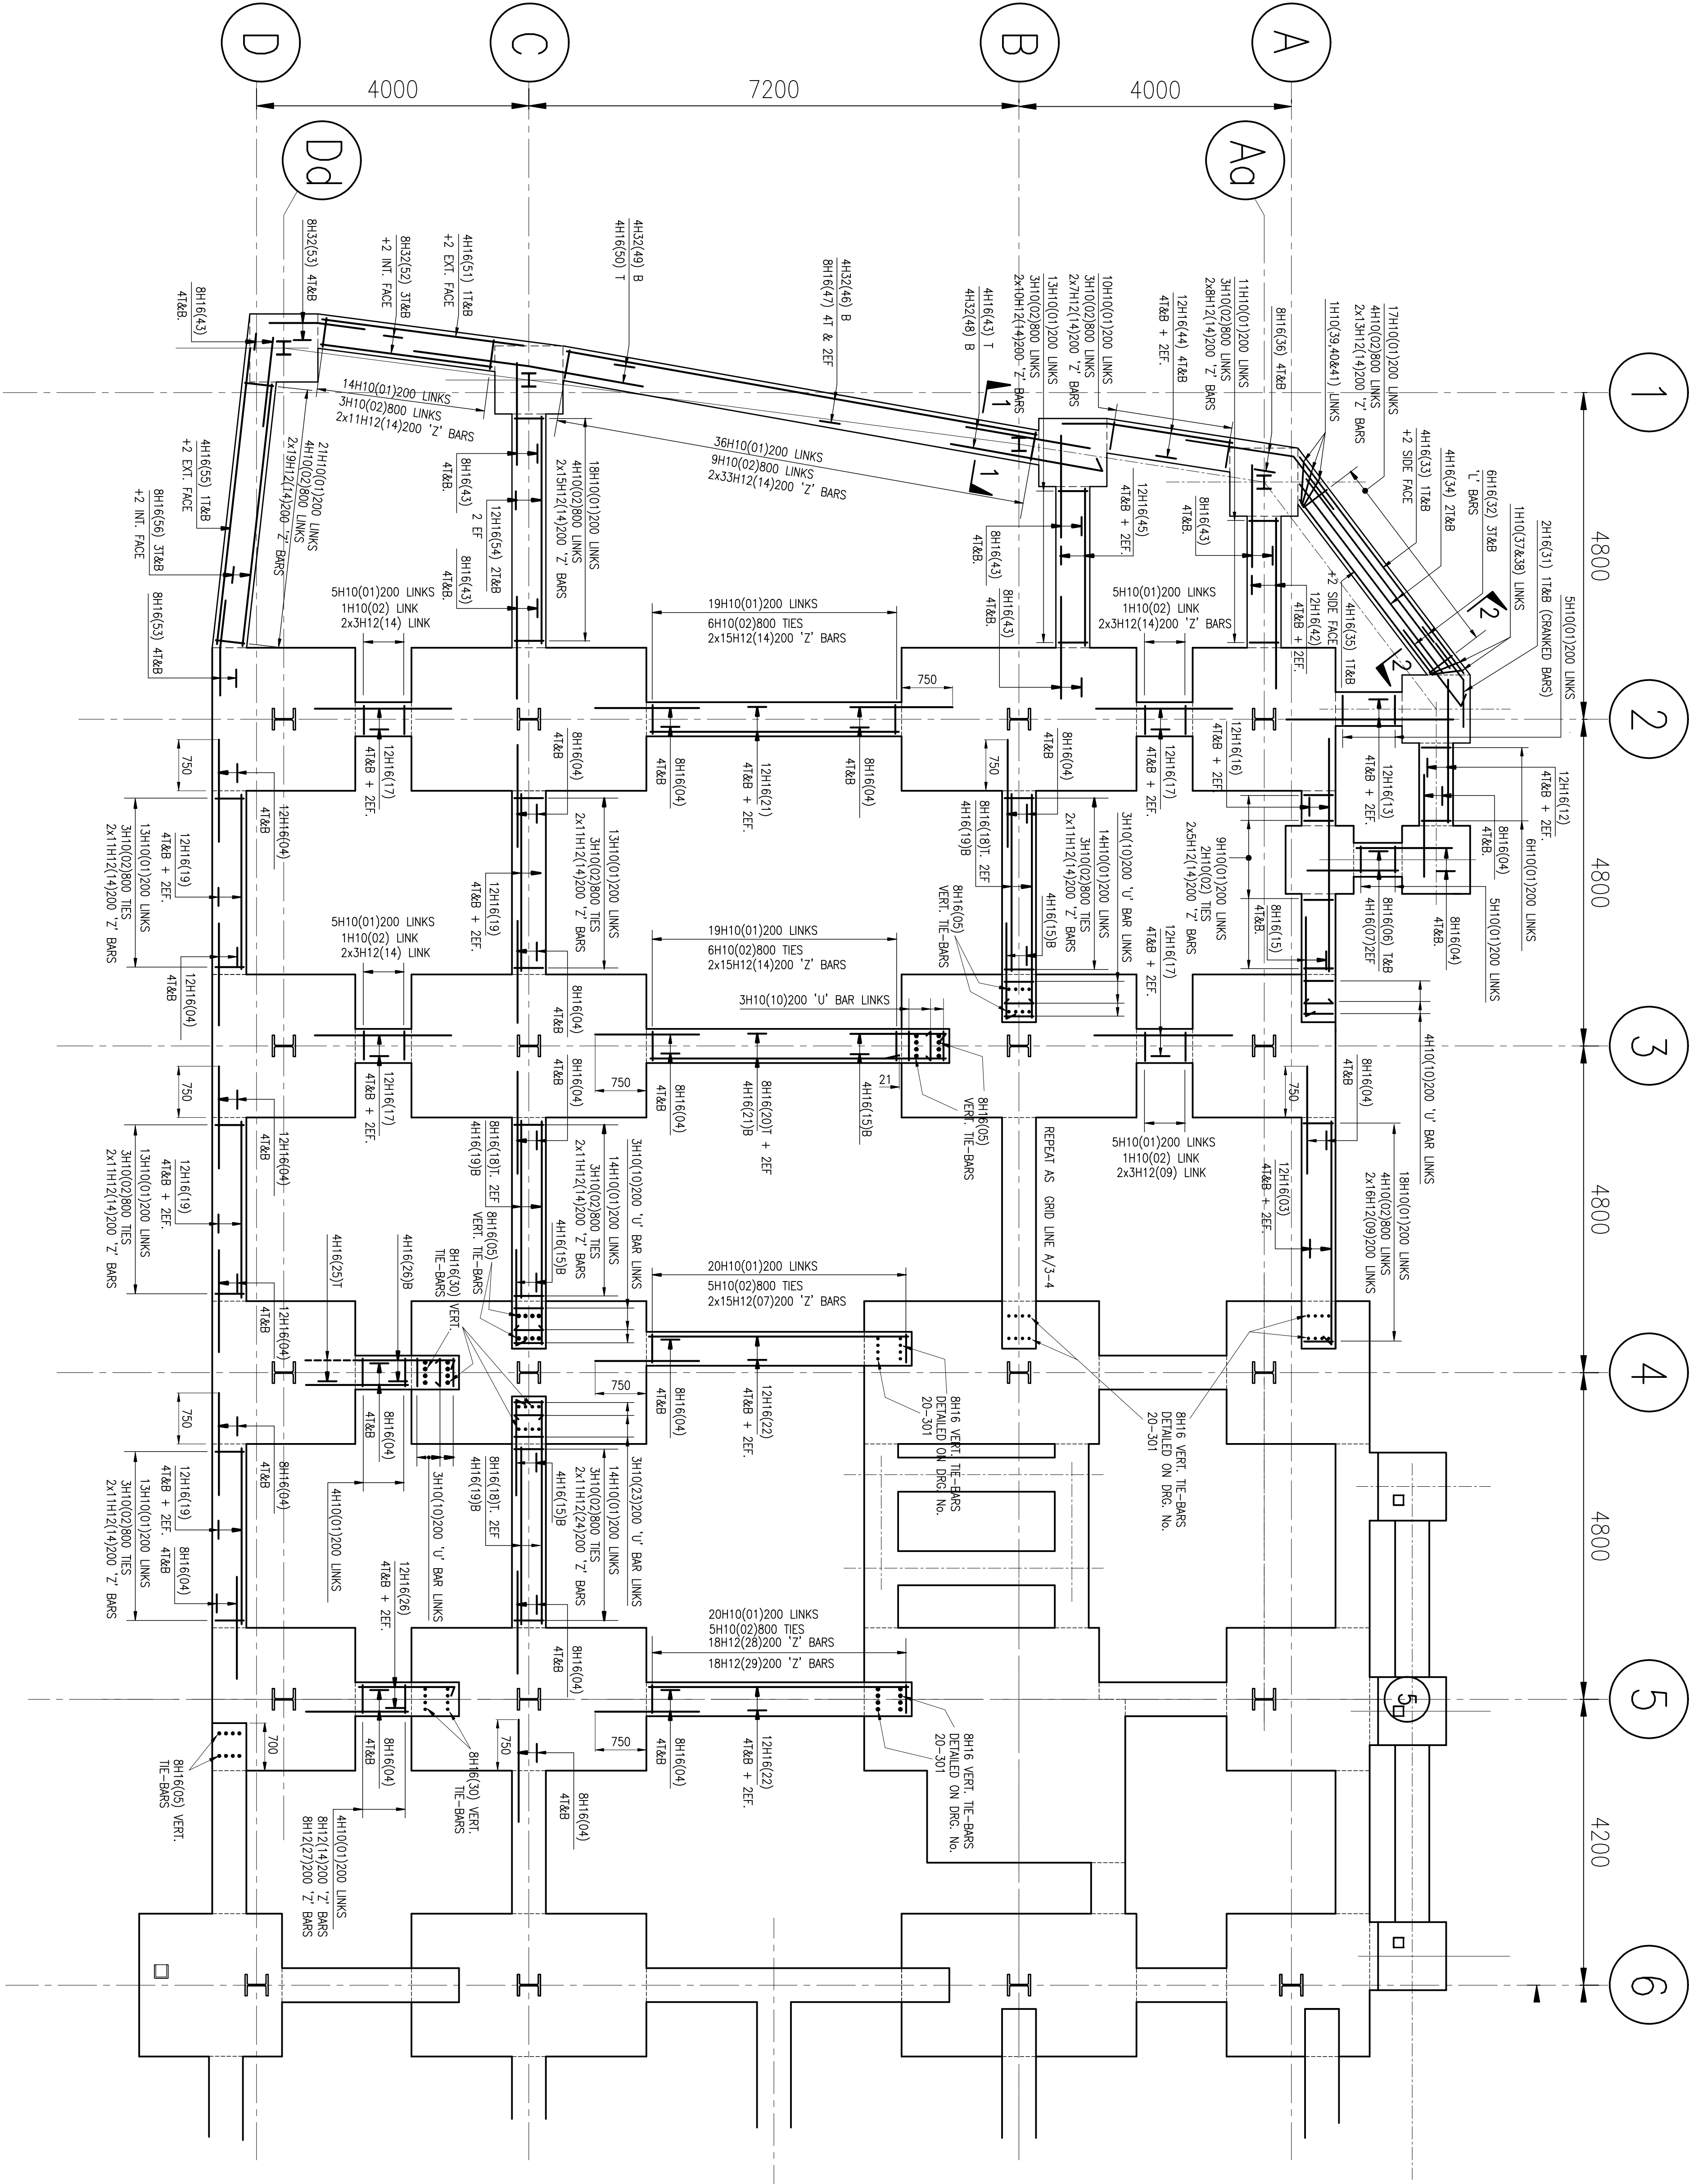

SEJC Consulting Engineers
Consulting Structural & Civil Engineers
Sanderson House, Station Road, Haverhill, Leamington Spa, CV35 9EF
Telephone 0115 2500000 Fax 0115 2500040

DRAWING TITLE
RC. DETAILS OF GROUND BEAMS, GRIDS 1-5/A-D

SCALES 1:50, 1:25 (A40)
CONTRACT No. 501180C
20-303

STATUS:-
AS BUILT

DRAWN BY: SA. DATE: 26/4/02
CHECKED BY: DML. DATE: 26/4/02
PROJECT ENGINEER: DML. DATE: 26/4/02

CLIENT: CTP'S JAMES
ARCHITECT: FaulknerBrown

CONTRACTOR: WAKEFIELD WATERFRONT
PHASE 1,
BUILDING 20