

- NOTES
1. ALL MATERIALS AND WORKMANSHIP TO BE STRICTLY IN ACCORDANCE WITH THE SPECIFICATION AND ALL RELEVANT BRITISH STANDARDS.
 2. ABBREVIATIONS
B-BOTTOM T-TOP
EF-EACH FACE NF-NEAR FACE FF-FAR FACE
AB-ALTERNATE BARS.
ABS-ALTERNATE BARS STAGGERED
ABR-ALTERNATE BARS REVERSED
 3. ALL REINFORCEMENT TO BE HIGH YIELD TYPE B500A, B500B OR B500C RIBBED BARS TO BS4449:2005.
 4. BENDING AND SCHEDULING OF REINFORCEMENT TO BE IN ACCORDANCE WITH BS 8666 : 2005
 5. CONCRETE COVER TO ALL REINFORCEMENT TO BE 40mm UNLESS NOTED OTHERWISE.
 6. REINFORCEMENT DETAIL ON THIS DRAWING IS SCHEDULED ON BAR LISTS Nos 307/1 & 2.
 7. THIS DRAWING TO BE READ IN CONJUNCTION WITH RELEVANT ARCHITECTS DRAWINGS & SEJC DETAILS.
 8. ALL KICKERS TO BE 150 HIGH.

MK	REVISIONS		BY	DATE
				CHK

STATUS:—	
AS BUILT	
DRAWN BY __ __ BT.	DATE __ __ APRIL '07
CHECKED BY __ __	DATE __ __
PROJECT ENGINEER __ __	DATE __ __

CLIENT.

CTP


S JAMES

ARCHITECT.

FaulknerBrowns

CONTRACT

WAKEFIELD WATERFRONT
PHASE 1,
BUILDING 20

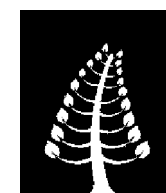

SEJC Consulting Engineers
Consulting Structural & Civil Engineers

Sanderson House, Station Road, Horsforth, Leeds LS18 5NT
Telephone 0113 2580090 Fax 0113 2586640

DRAWING TITLE			
RC DETAILS OF BASEMENT WALLS.			
SHEET 1.			
SCALES 1:50 & 1:25			
CONTRACT No	DRG No		
501180C	20-307		