



TO BE READ IN CONJUNCTION
WITH BAR SCHEDULE No.
5011800/20-308-(03)

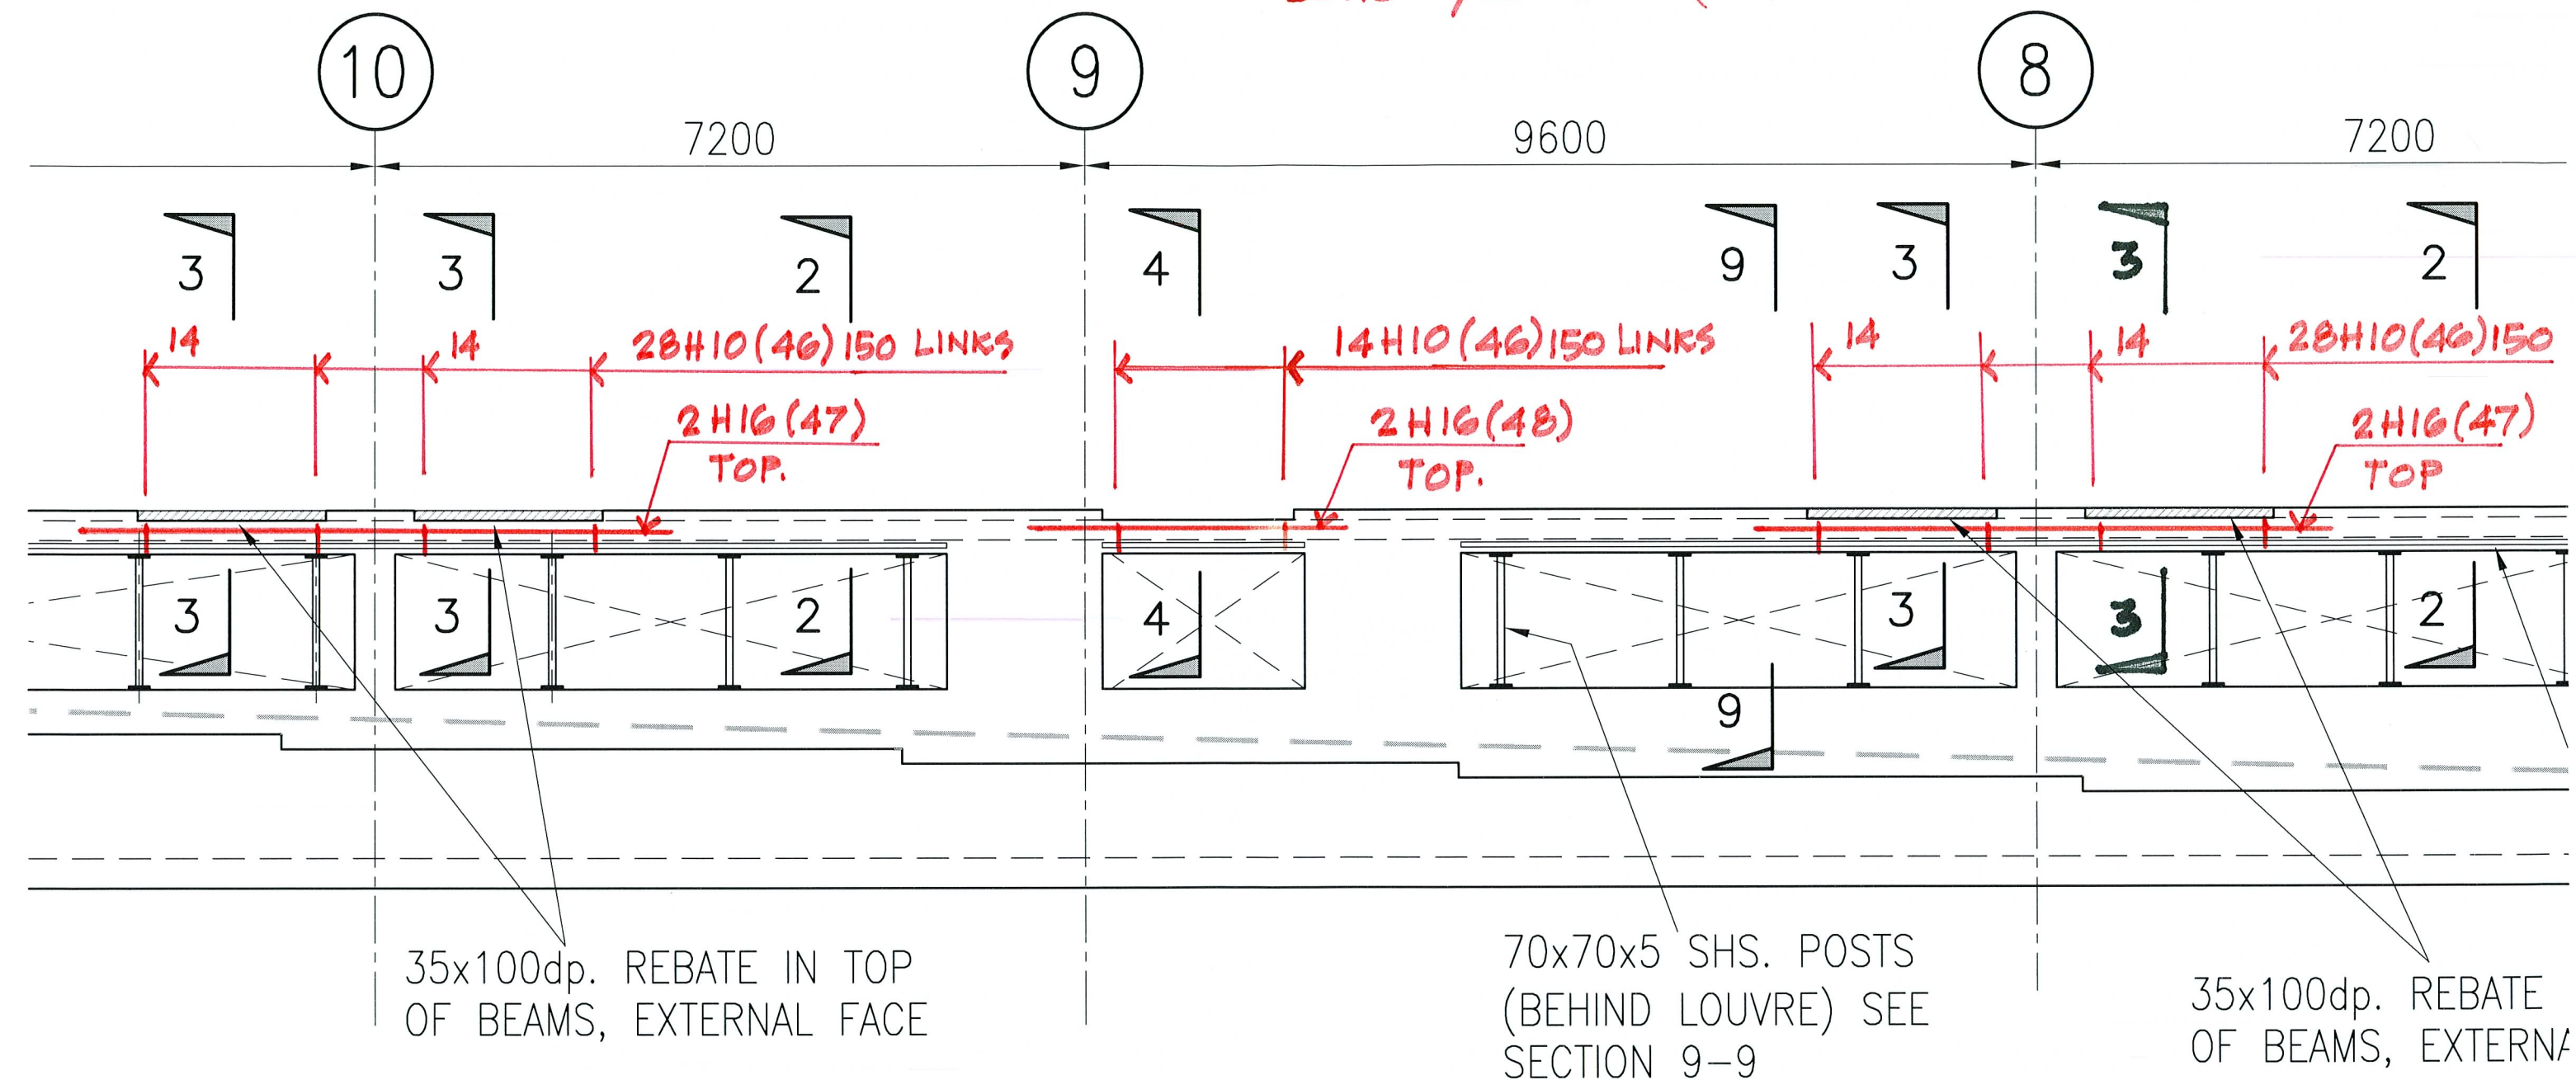

EXTERNAL ELEVATION ON WALL 'A' (ADJ. GRIDLINE 'A')

NOT TO SCALE


TO BE READ IN CONJUNCTION
WITH BAR SCHEDULE No. 501180C/20-309 (04)

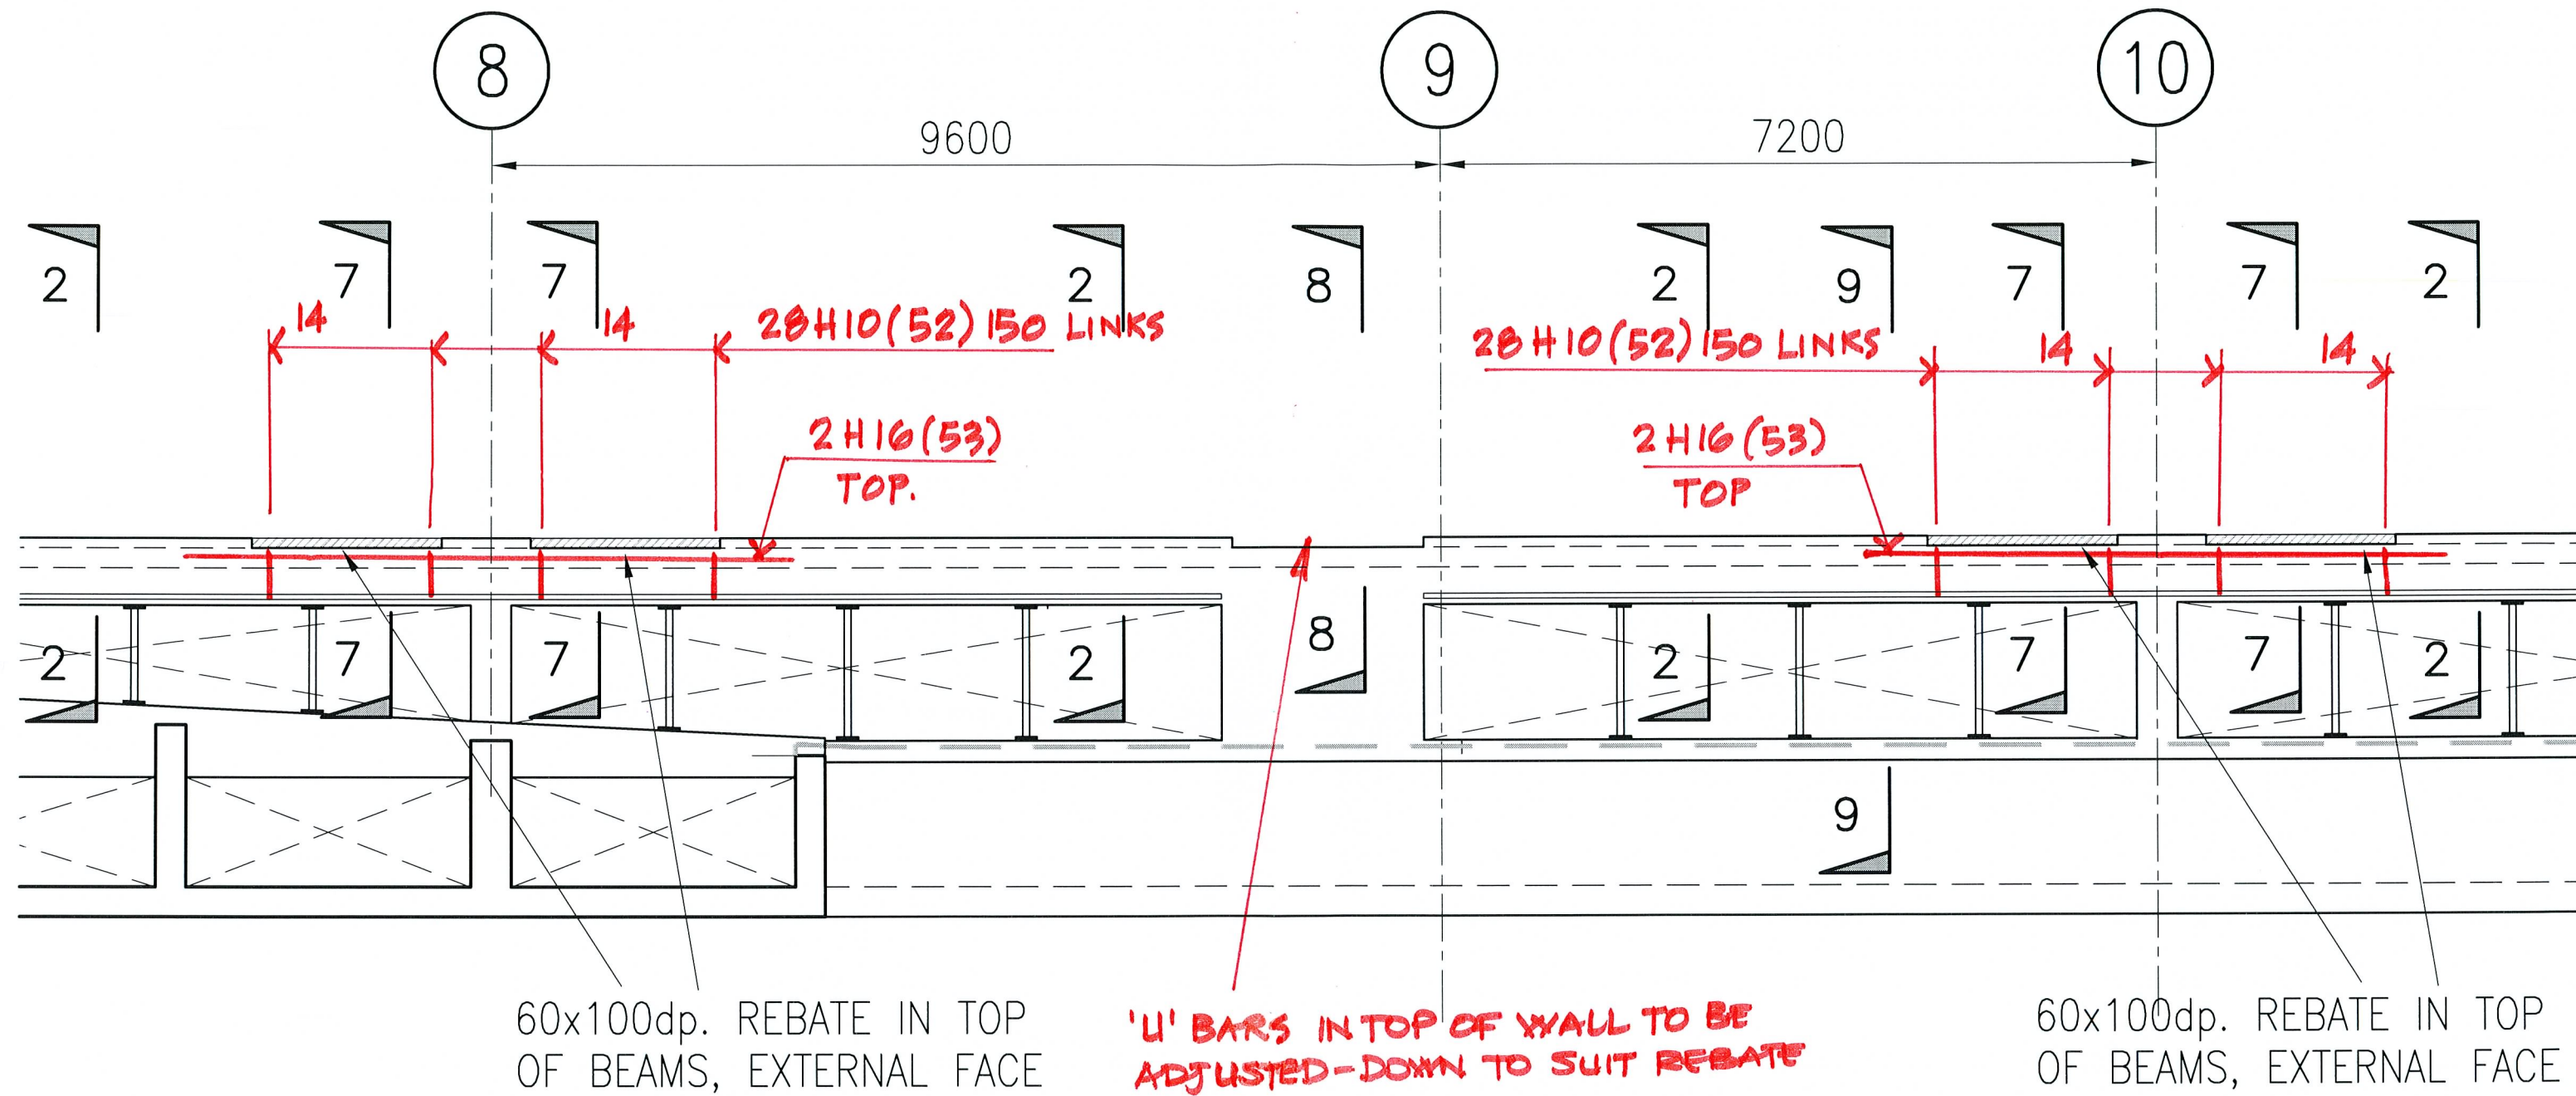


EXTERNAL ELEVATION ON WALL 'B' (ADJ. GRIDLINE 'D')

NOT TO SCALE


EXTRACT FROM SEJC. DRG. No. 501180C/20-009

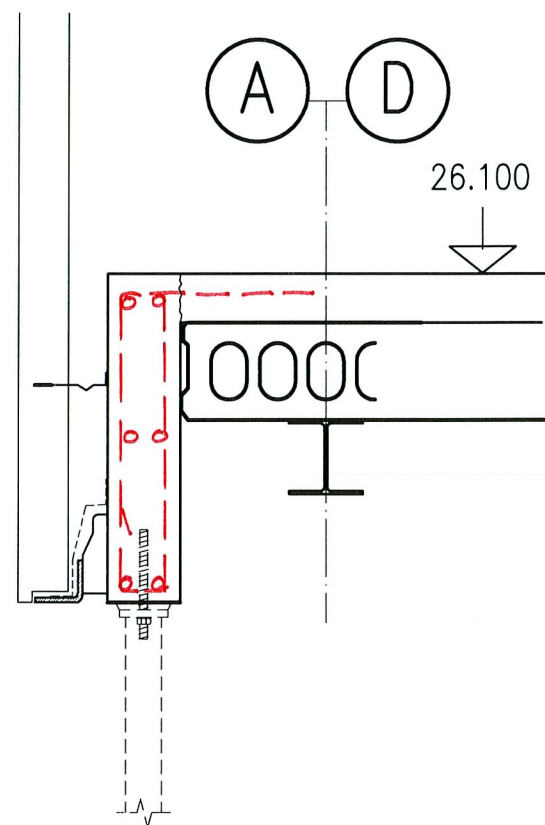


SECTION 2-2

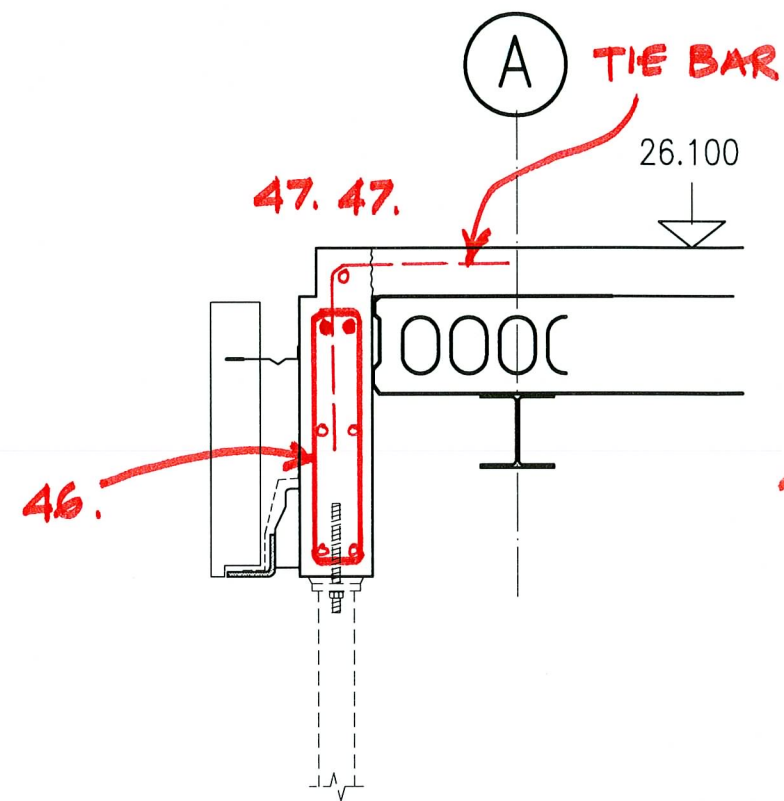


SECTION 3-3

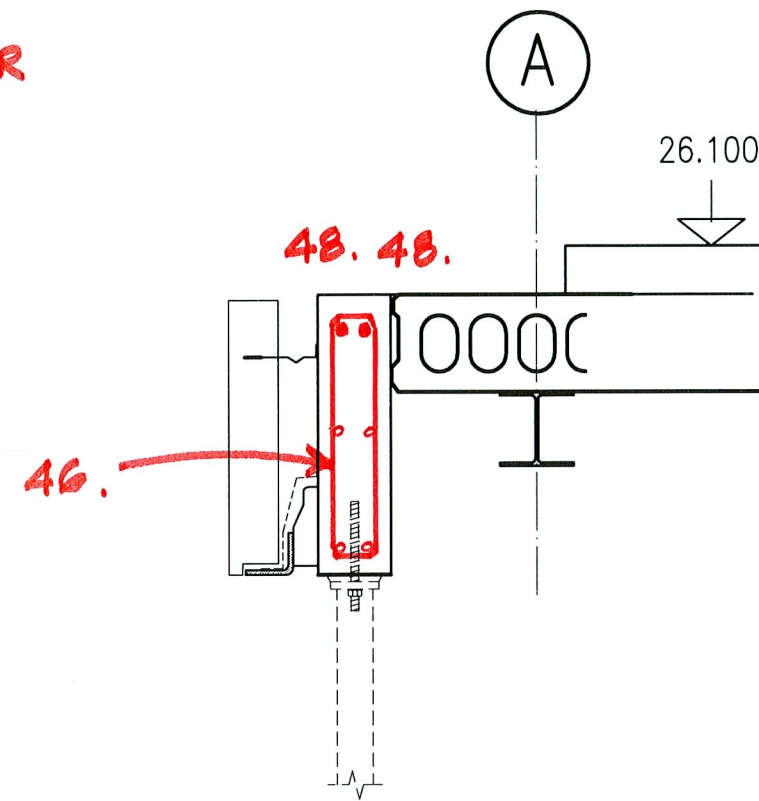


SECTION 4-4

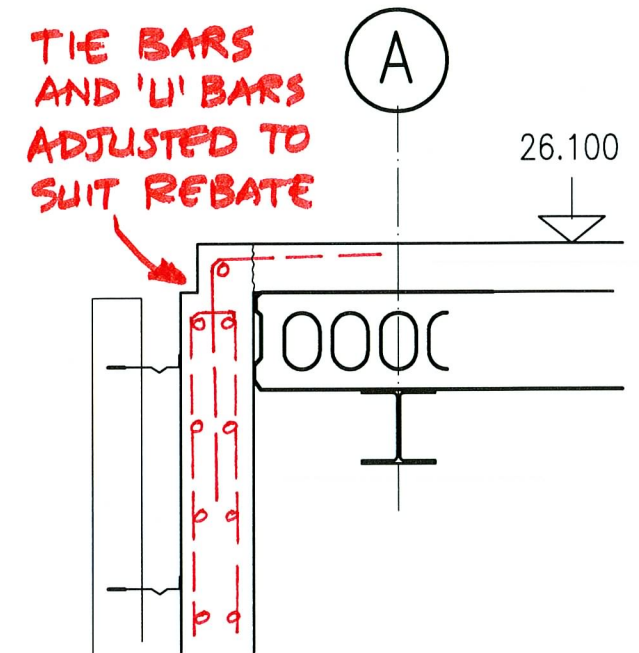


SECTION 5-5

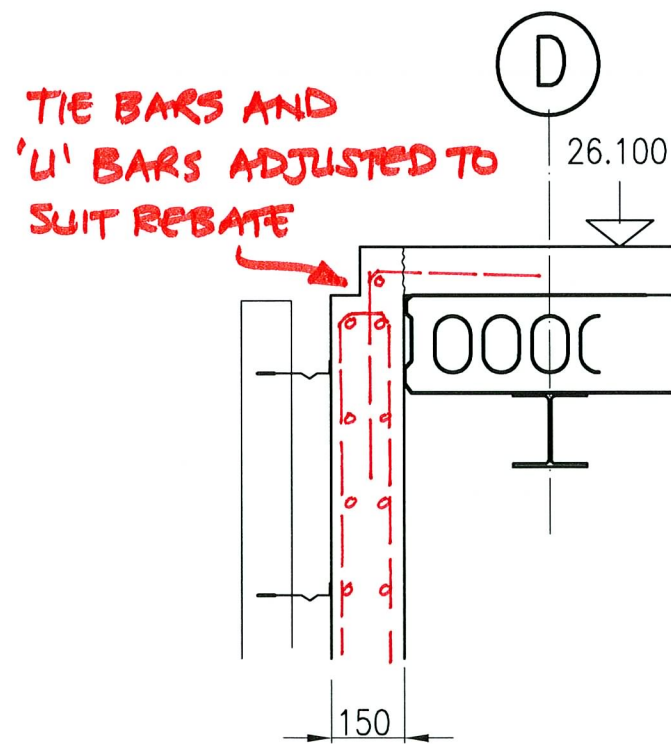

SECTION 6-6

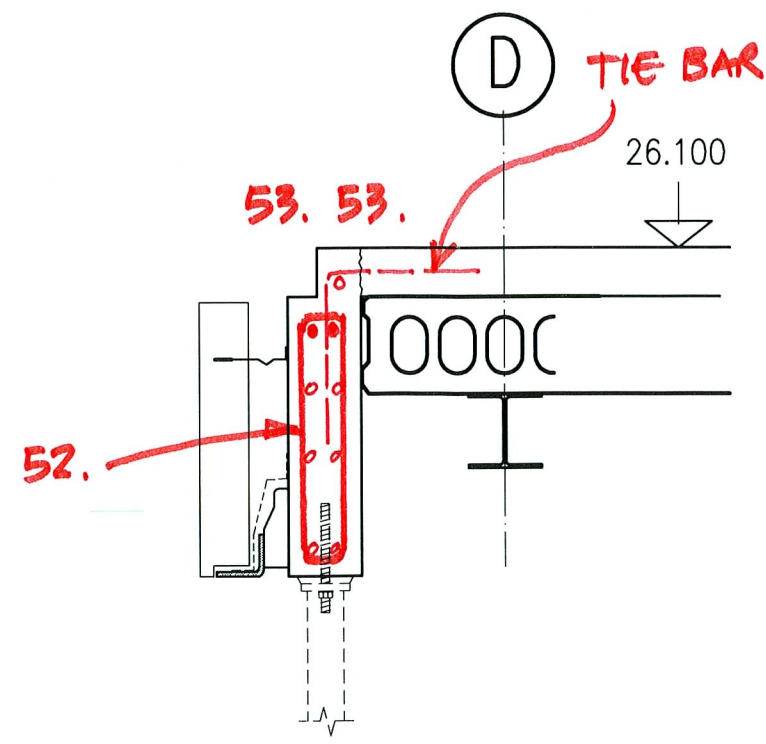

SECTION 7-7

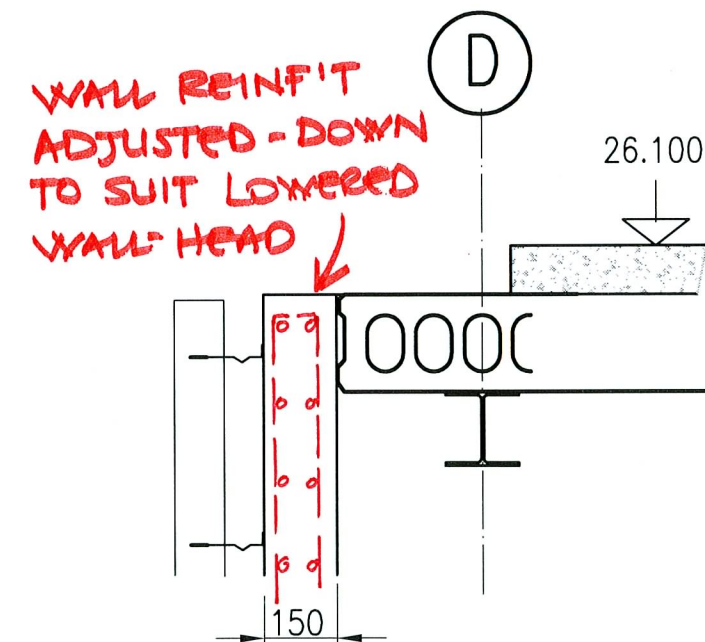

SECTION 8-8