

1. ALL MATERIALS AND WORKMANSHIP TO BE STRICTLY IN ACCORDANCE WITH THE SPECIFICATION AND ALL RELEVANT BRITISH STANDARDS.
2. ABBREVIATIONS  
B-BOTTOM T-TOP
3. ALL REINFORCEMENT TO BE HIGH YIELD TYPE B500A, B500B OR B500C RIBBED BARS TO BS4449:2005.
4. BENDING AND SCHEDULING OF REINFORCEMENT TO BE IN ACCORDANCE WITH BS 8666 : 2005
5. CONCRETE COVER TO ALL REINFORCEMENT TO BE 40mm UNLESS NOTED OTHERWISE.
6. REINFORCEMENT DETAILED ON THIS DRAWING IS SCHEDULED ON BAR LISTS Nos 322/1.
7. THIS DRAWING TO BE READ IN CONJUNCTION WITH RELEVANT ARCHITECTS DRAWINGS & SEJC DETAILS.

MK	REVISIONS	BY	DATE	CHK

STATUS:—

AS BUILT

DRAWN BY_ AK _ _ _ _ _	DATE_ 23.04.2008 _ _
CHECKED BY_ _ _ _ _	DATE_ _ _ _ _
PROJECT ENGINEER_ _ _ _ _	DATE_ _ _ _ _

CLIENT.


CTP	S <sup>t</sup> JAMES
-----	----------------------

ARCHITECT.

FaulknerBrowns

CONTRACT

WAKEFIELD WATERFRONT  
PHASE 1,  
BUILDING 20

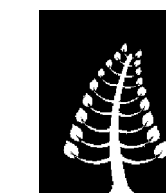

**SEJC Consulting Engineers**  
Consulting Structural & Civil Engineers

**Sanderson House, Station Road, Horsforth, Leeds LS18 5NT**  
**Telephone 0113 2590090 Fax 0113 2586840**

DRAWING TITLE

FOUNDATION BEAMS FOR  
EXTERNAL STAIRCASE

SCALES 1:100 1:25 @A1

CONTRACT No	DRG No
501180C	20-322