



NOTES


1. ALL TIMBER TO BE STRENGTH CLASS C24
2. FOR ALL DIMENSIONS REFER TO THE ARCHITECTS DRAWINGS.

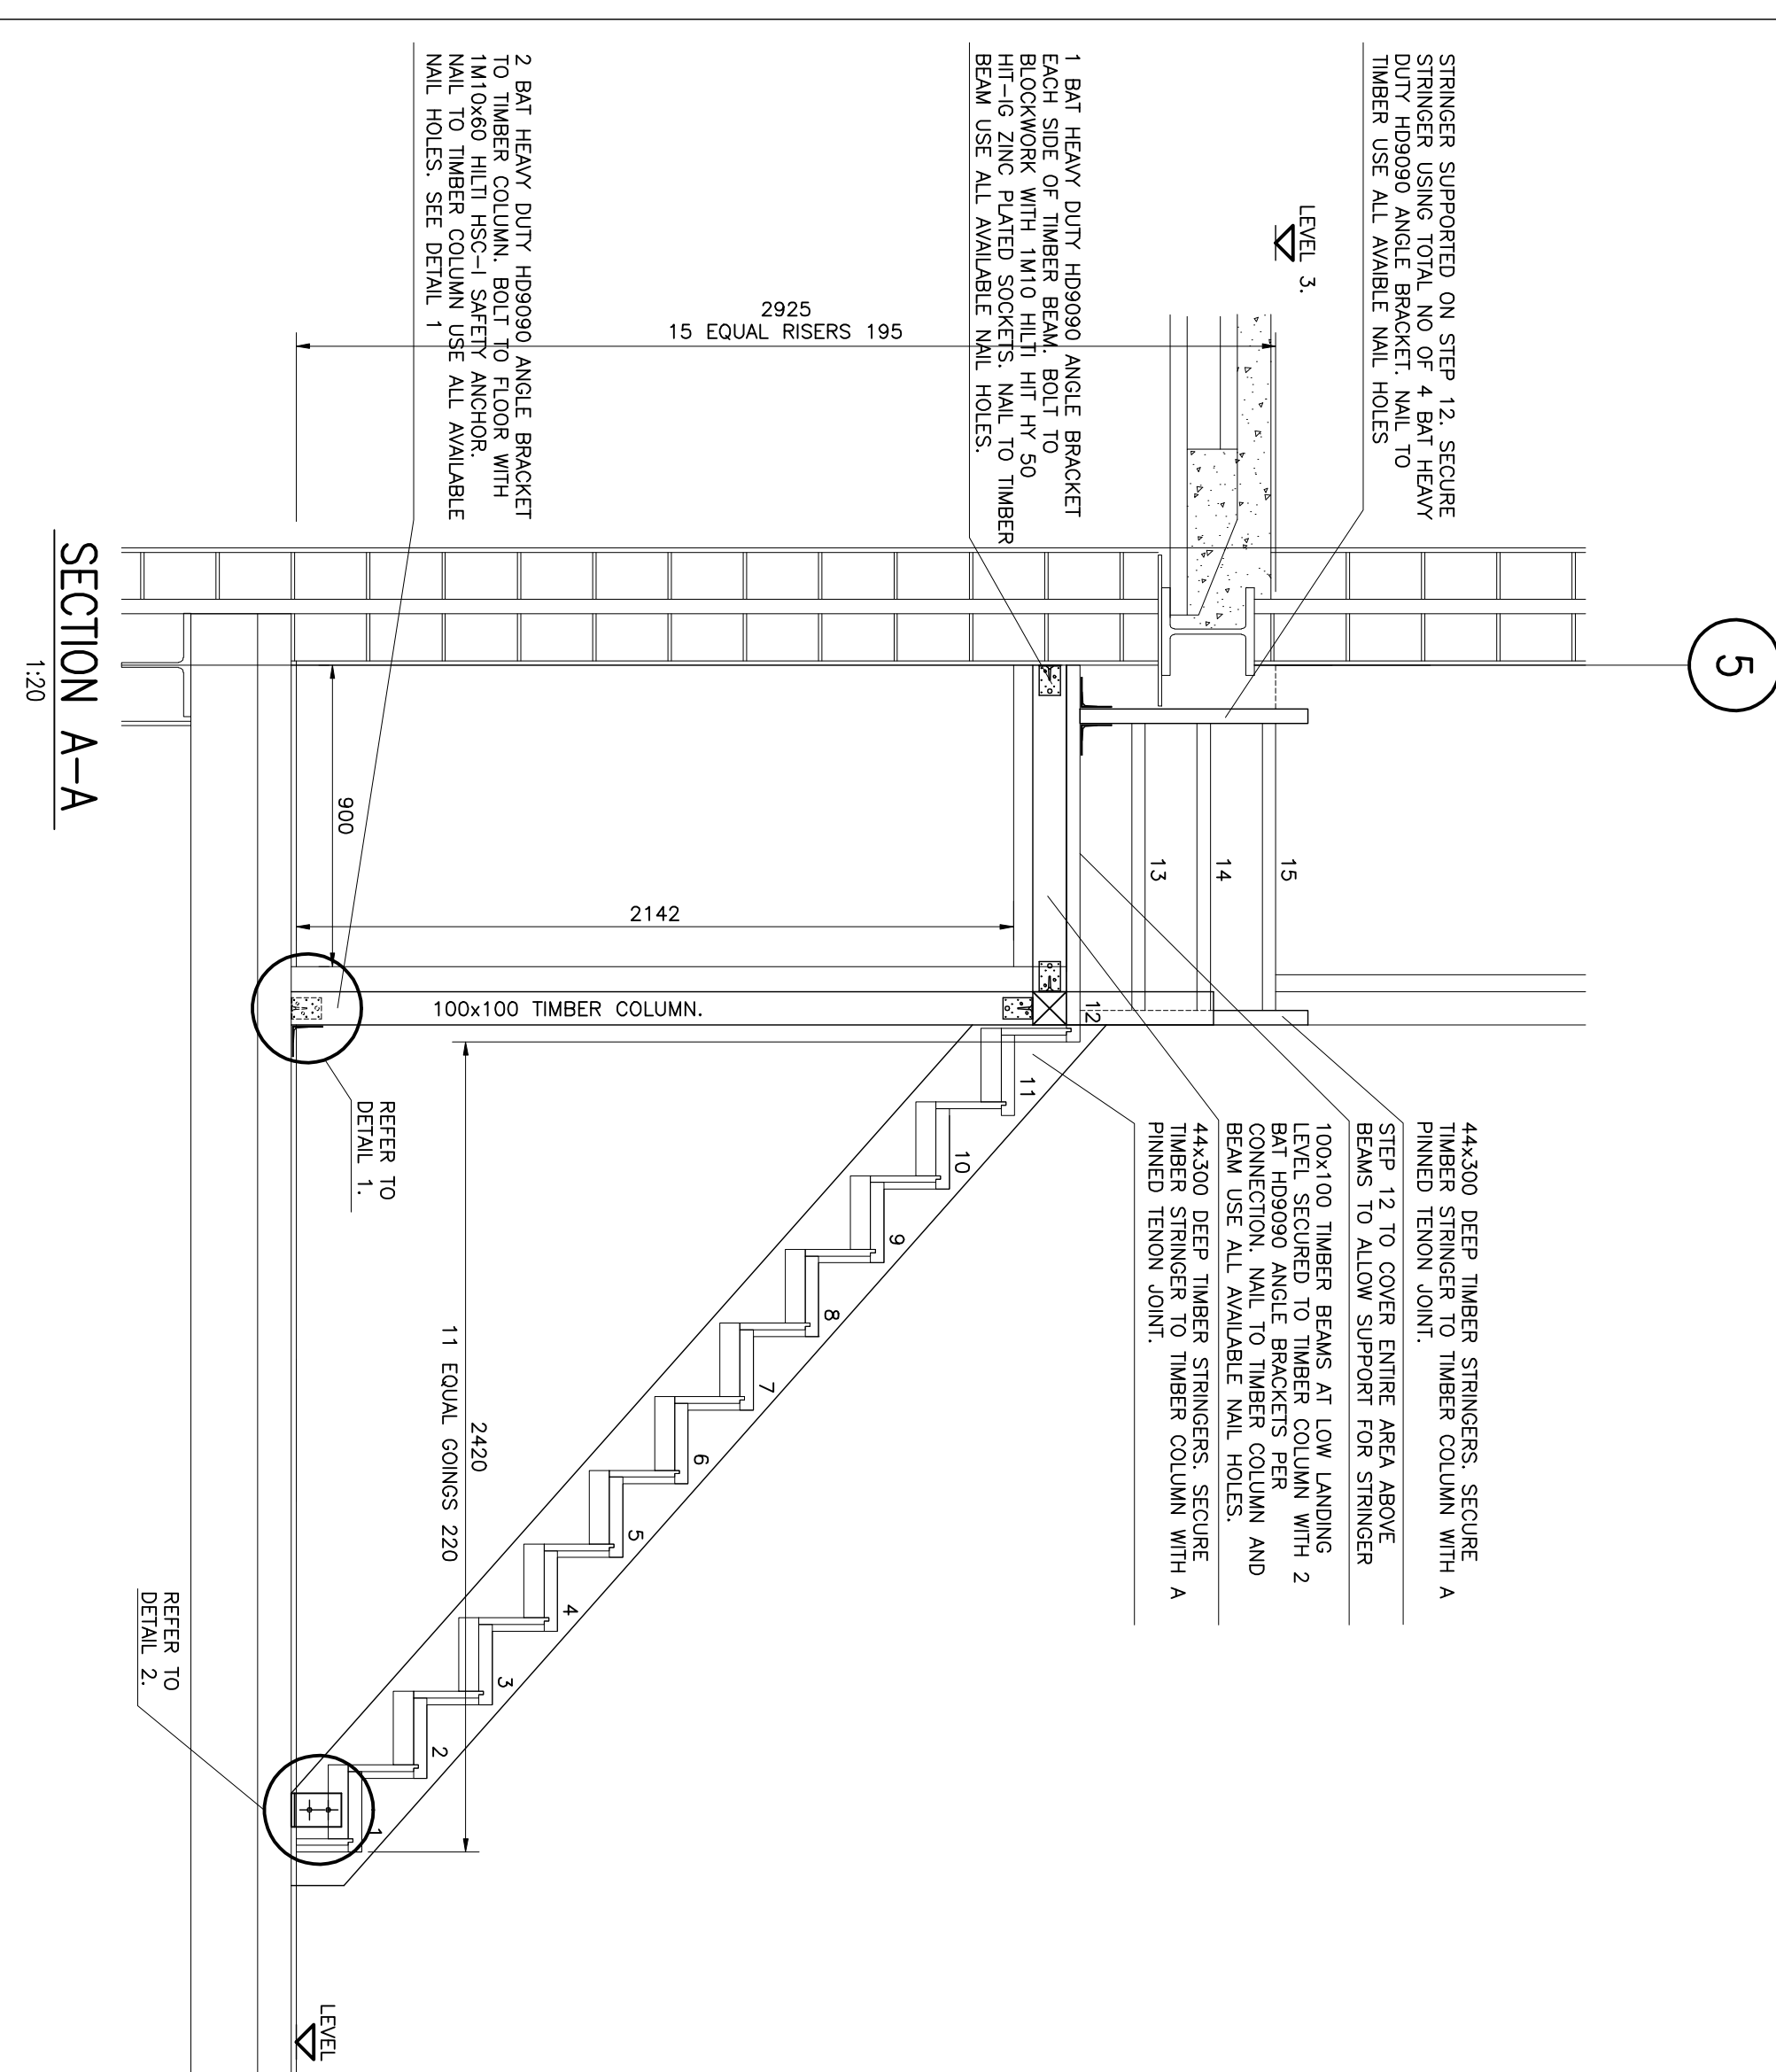

SECTION A-A

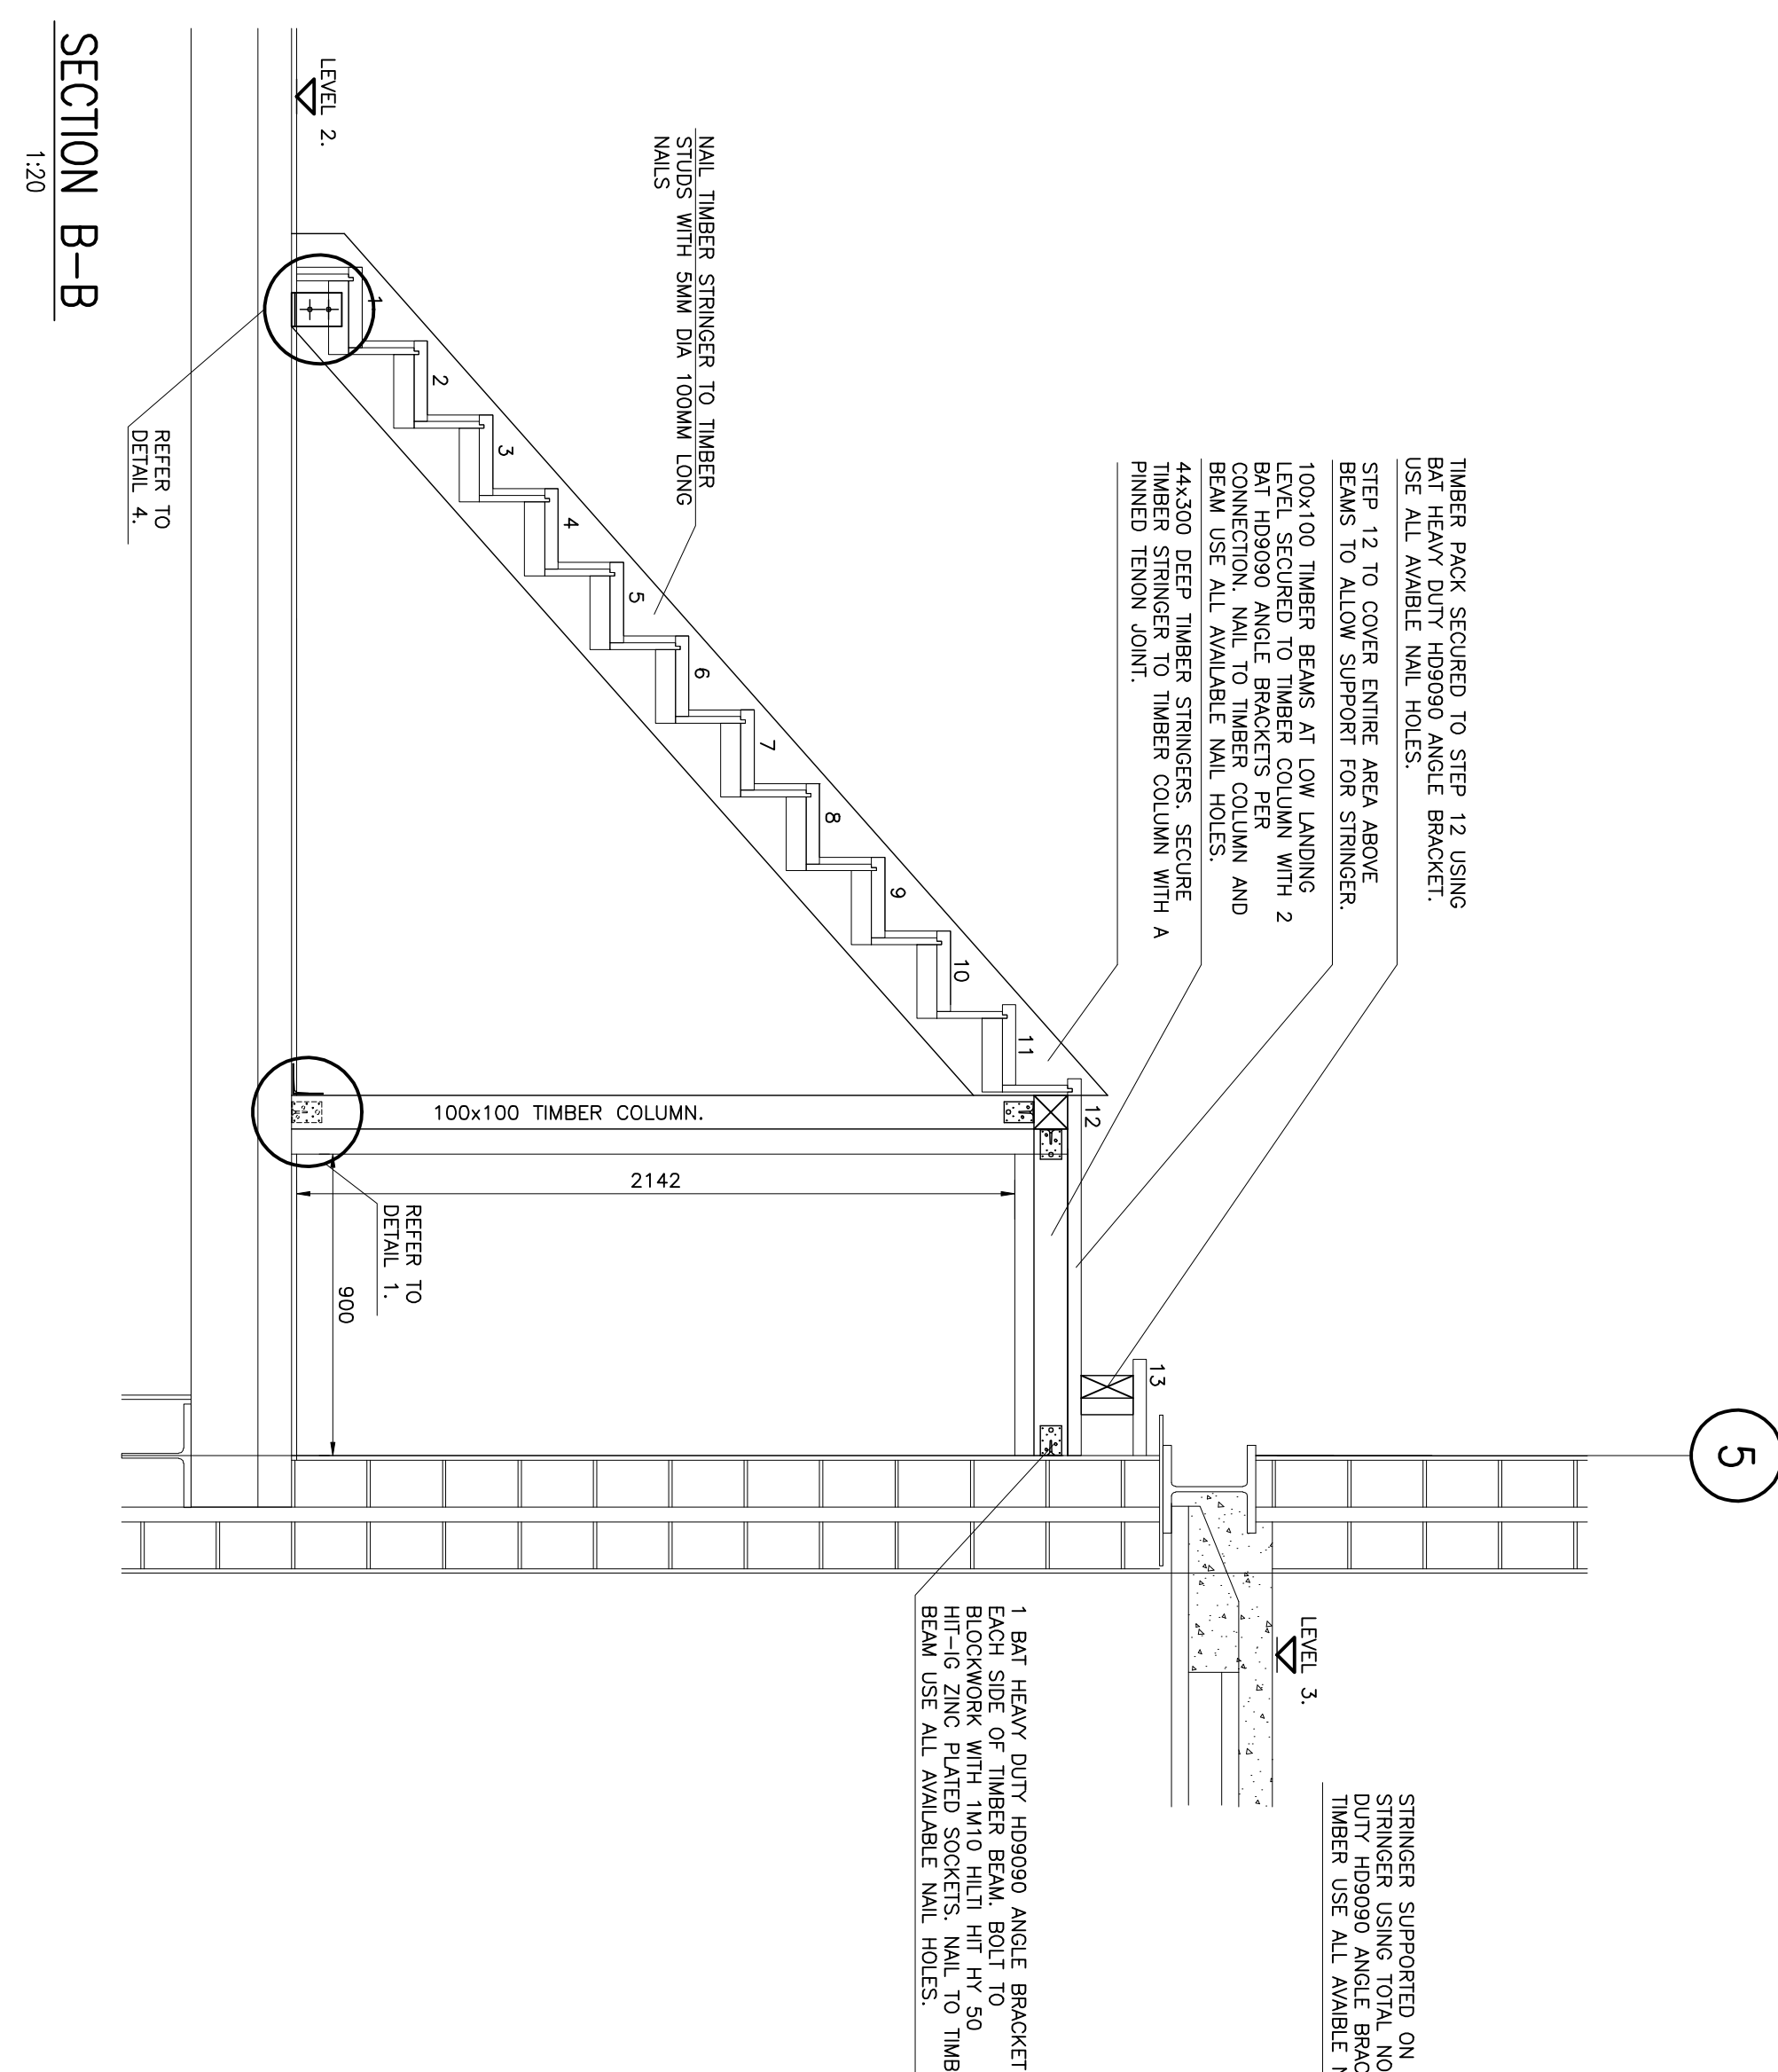


SECTION B-B
1-20

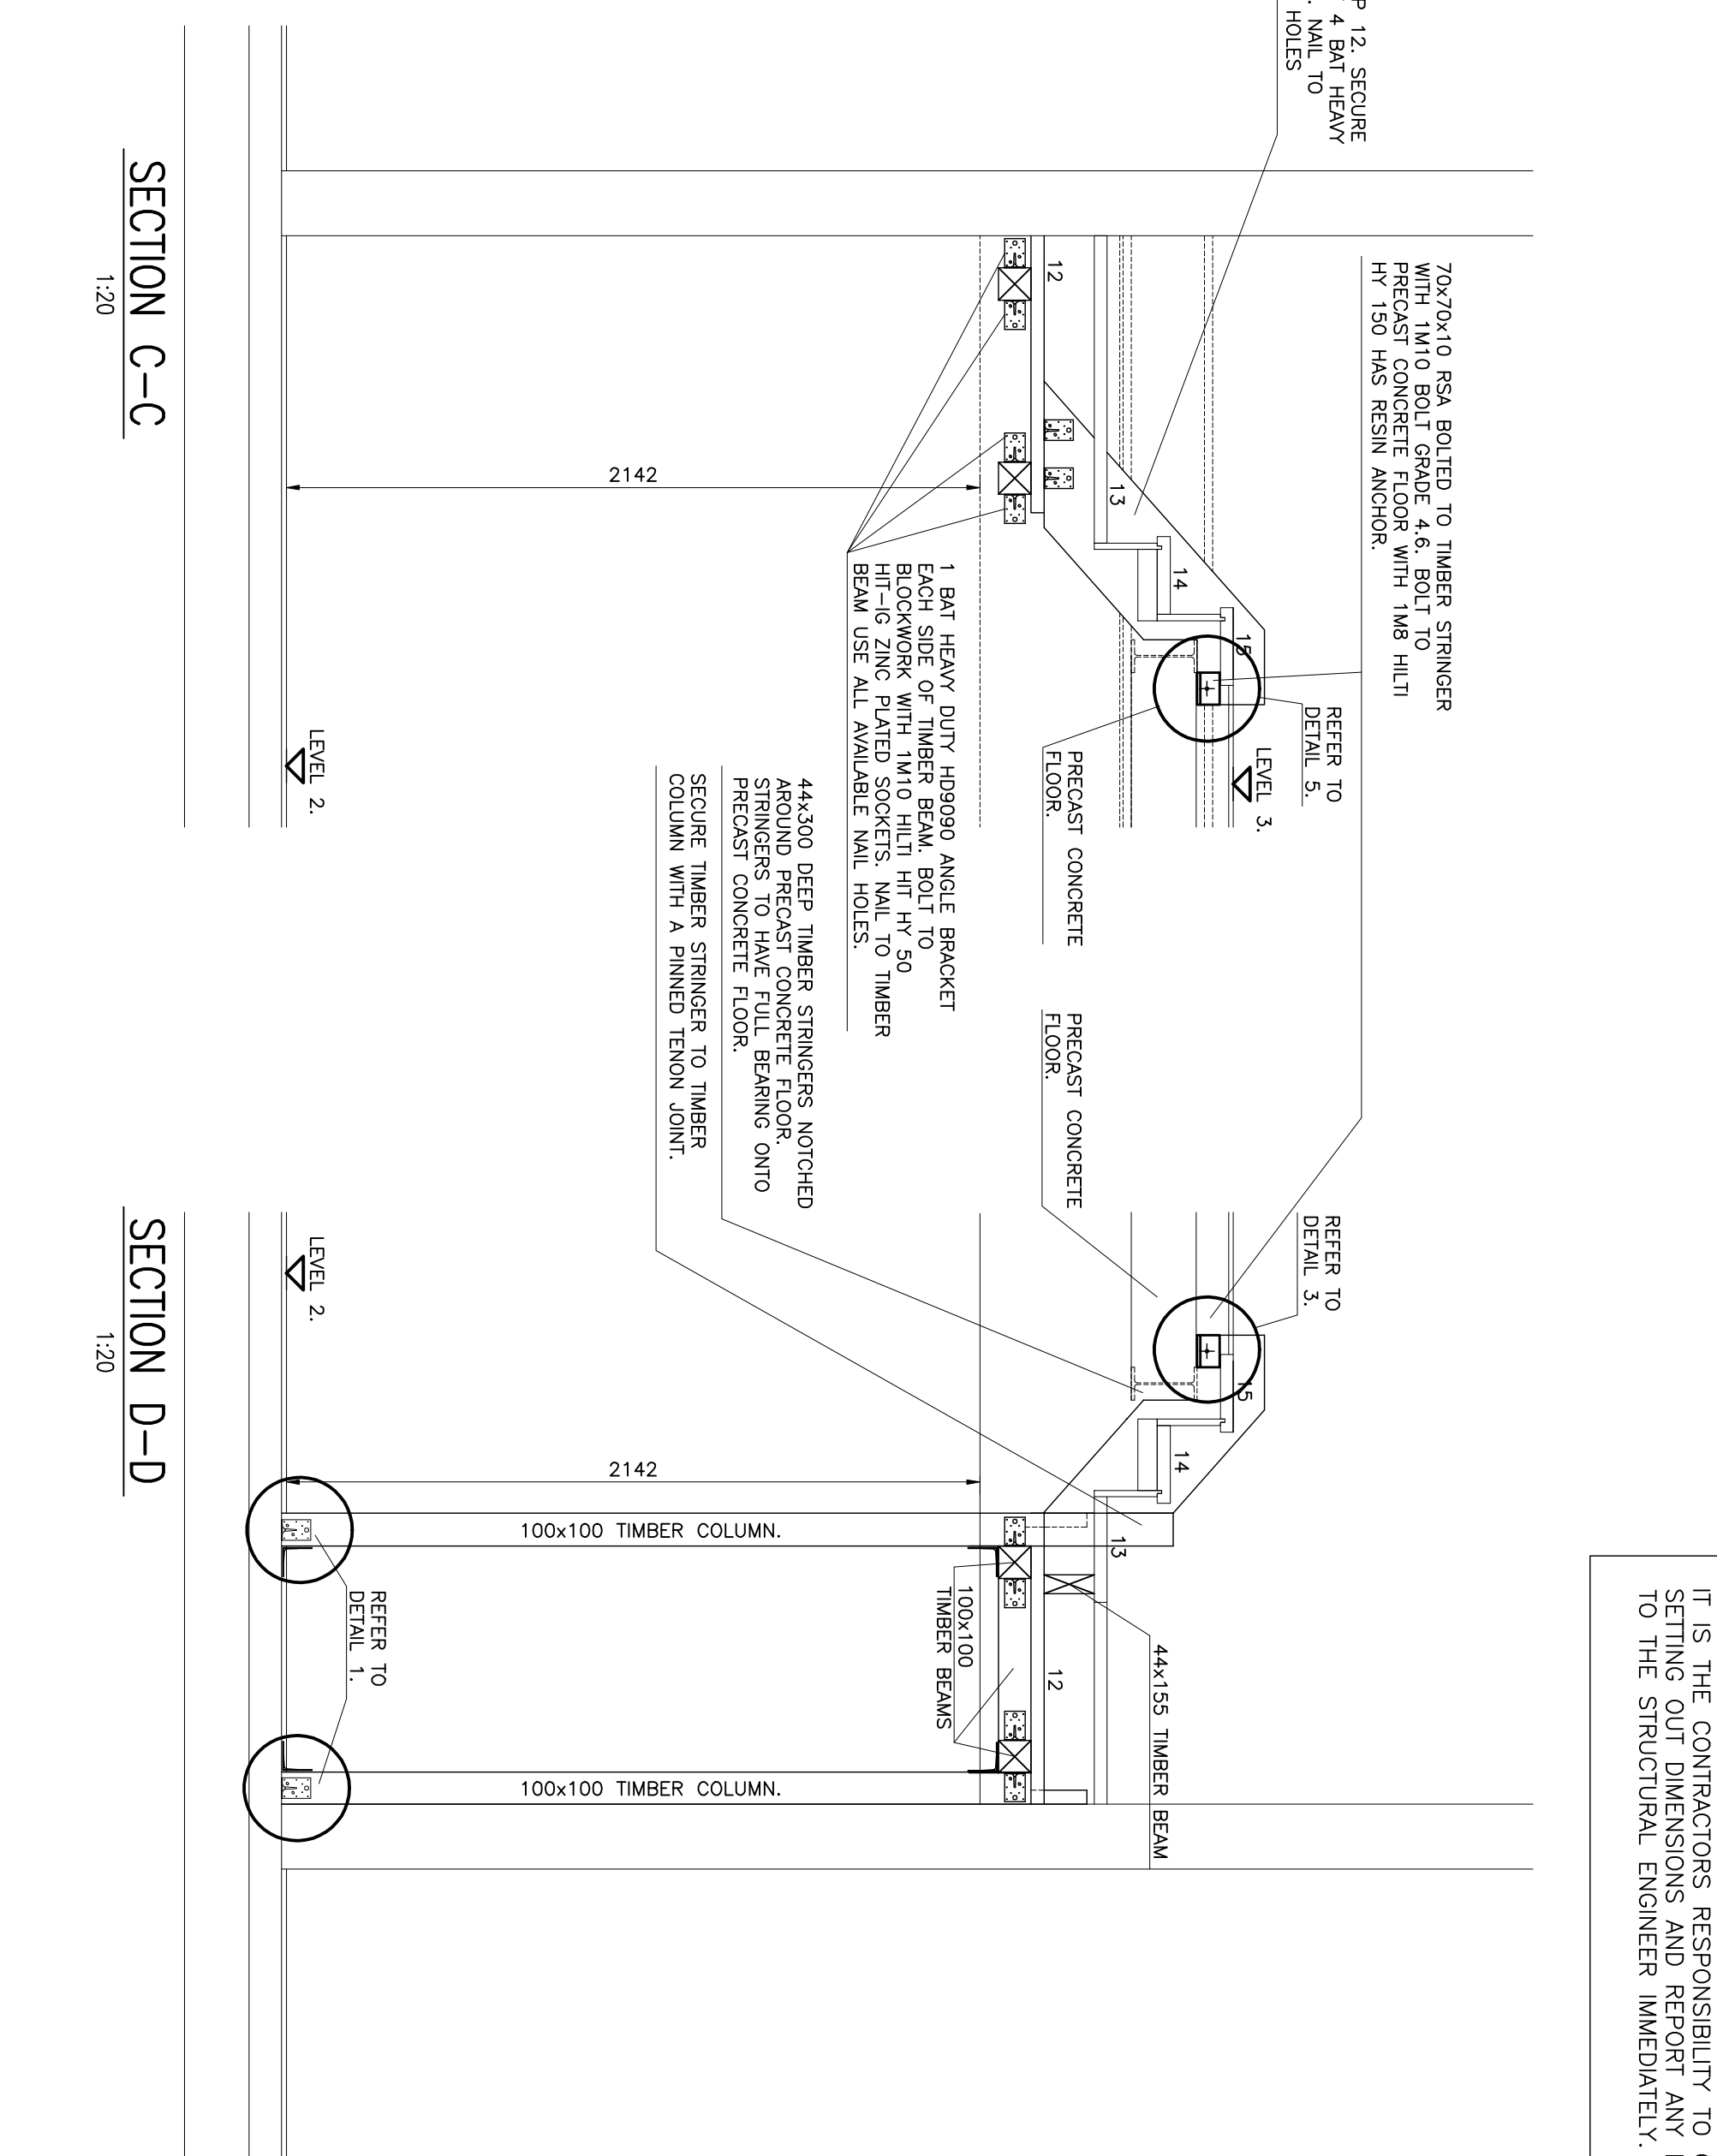


SECTION C-C
1:20


SECTION D-D
1:20

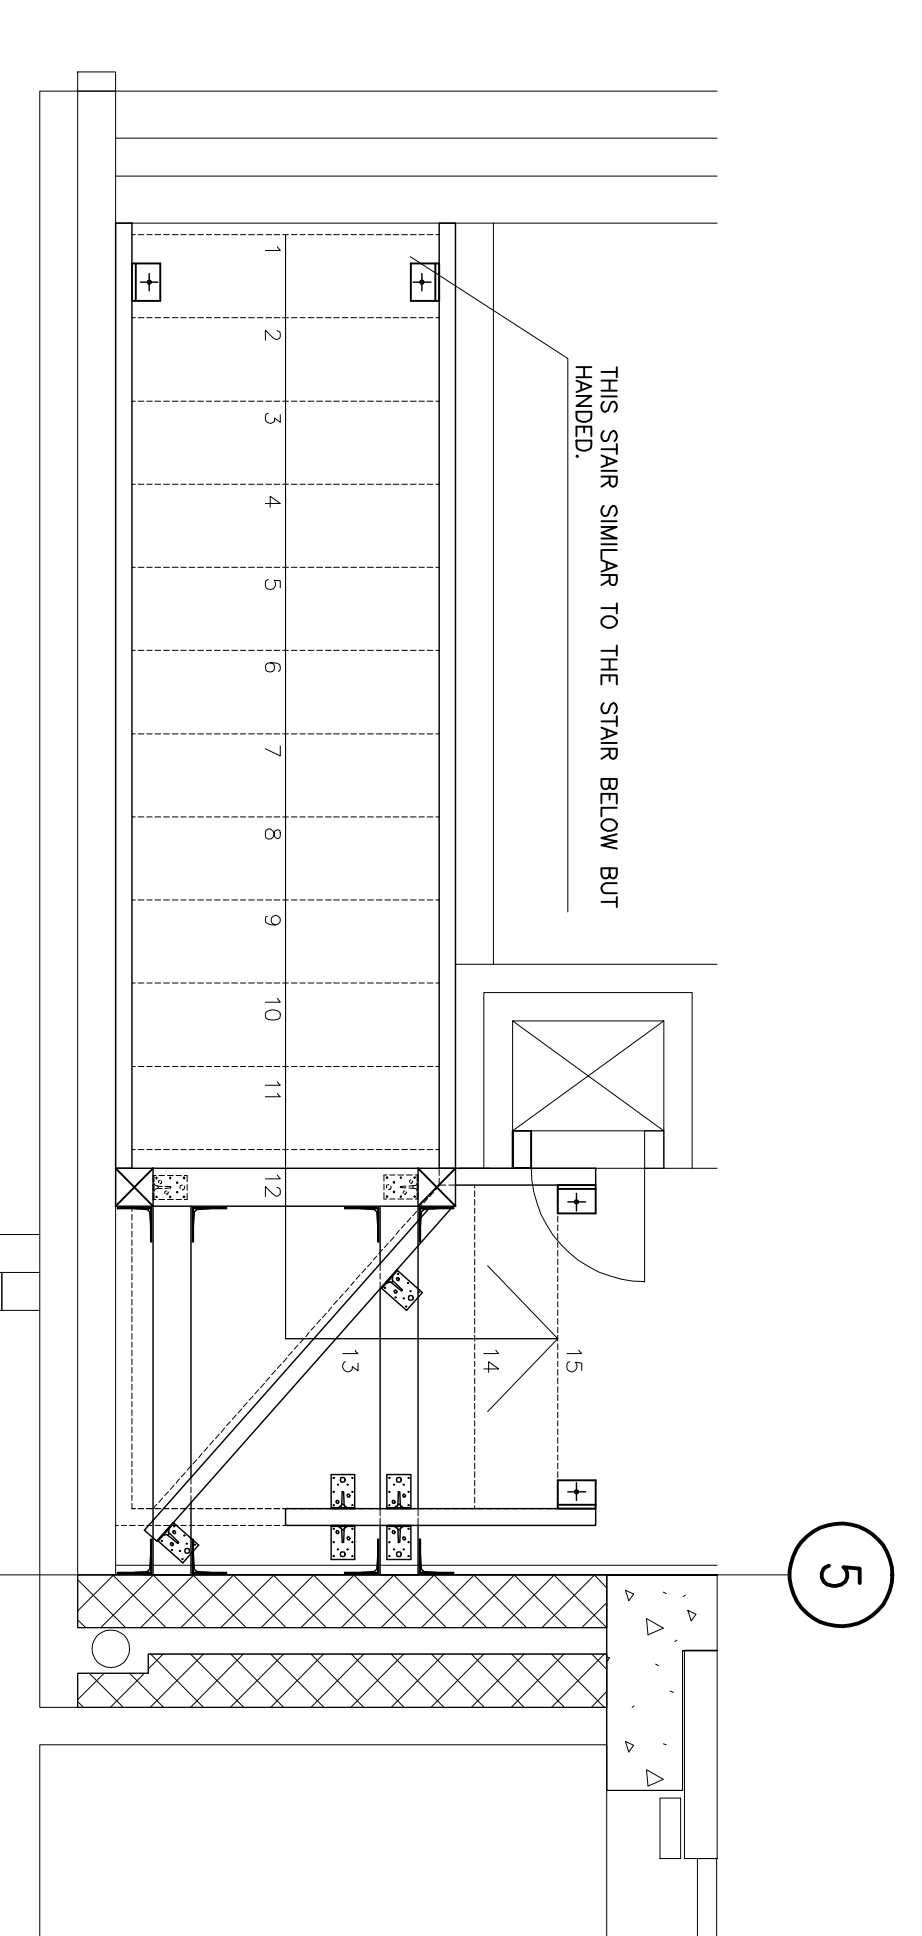


DETAIL 1 - PLAN
1:10

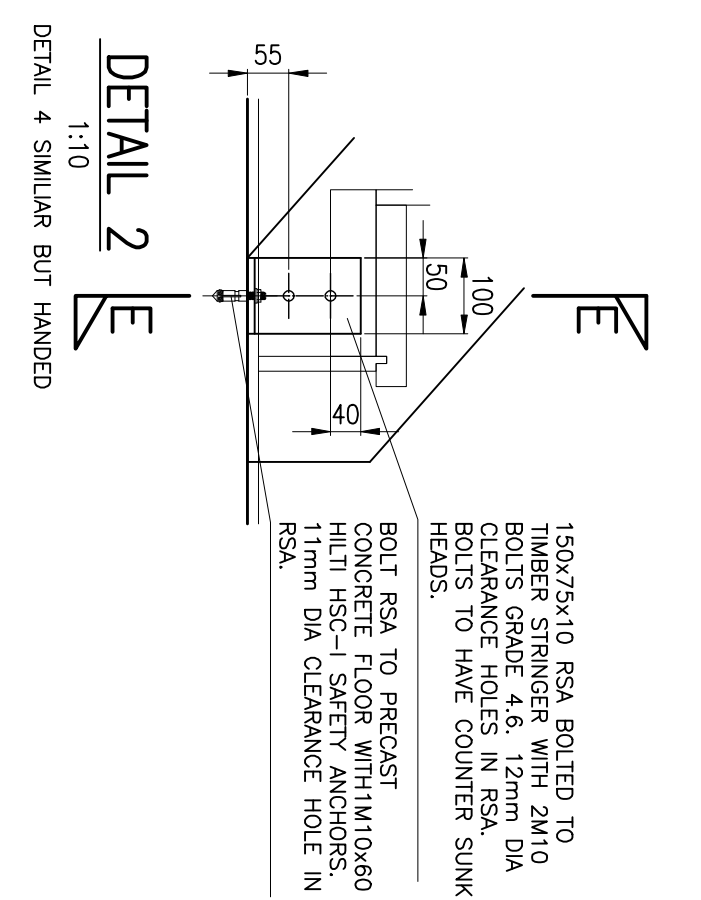


DETAIL 2
1:10

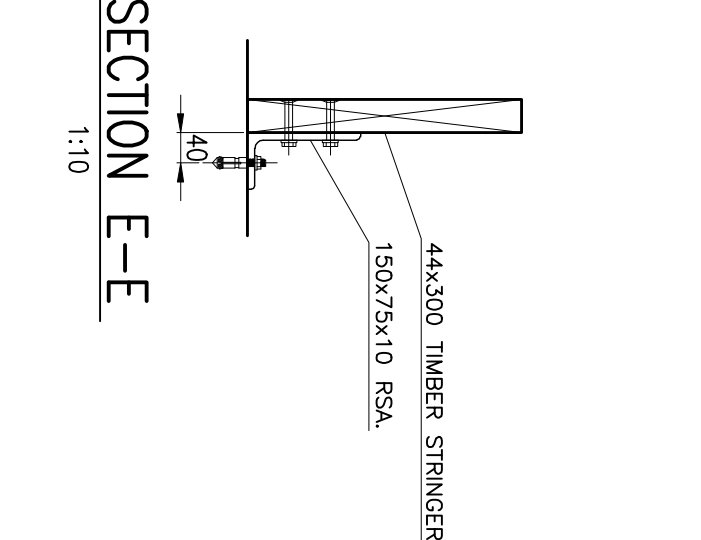


SECTION E-E
1:10

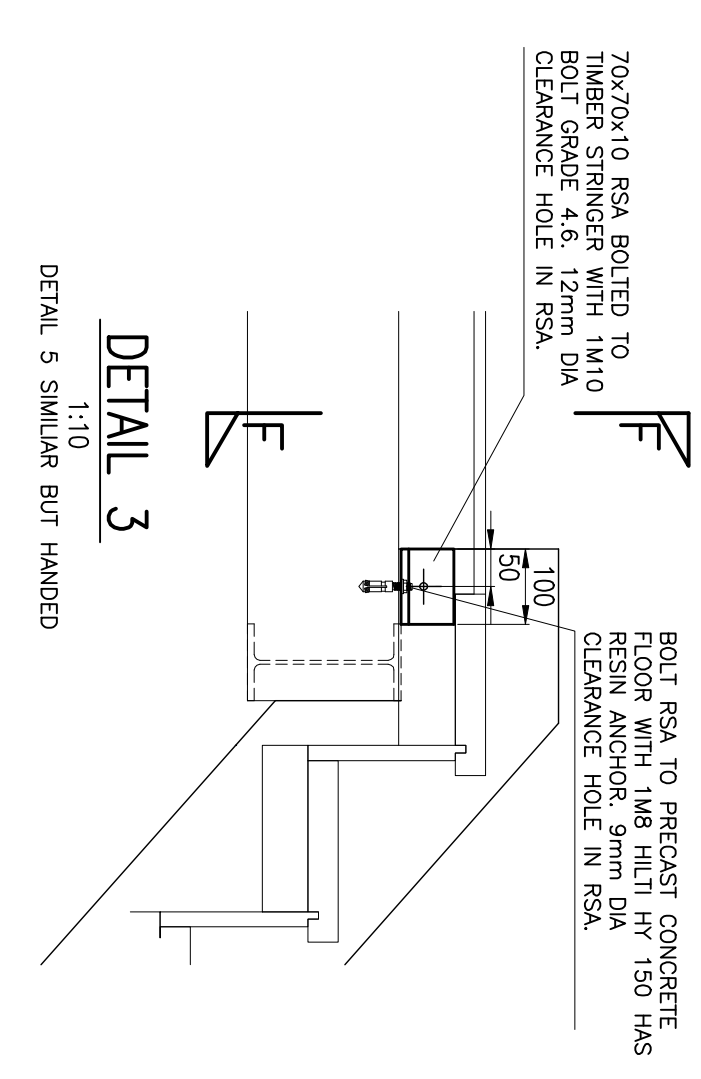


DETAIL 3
1:10

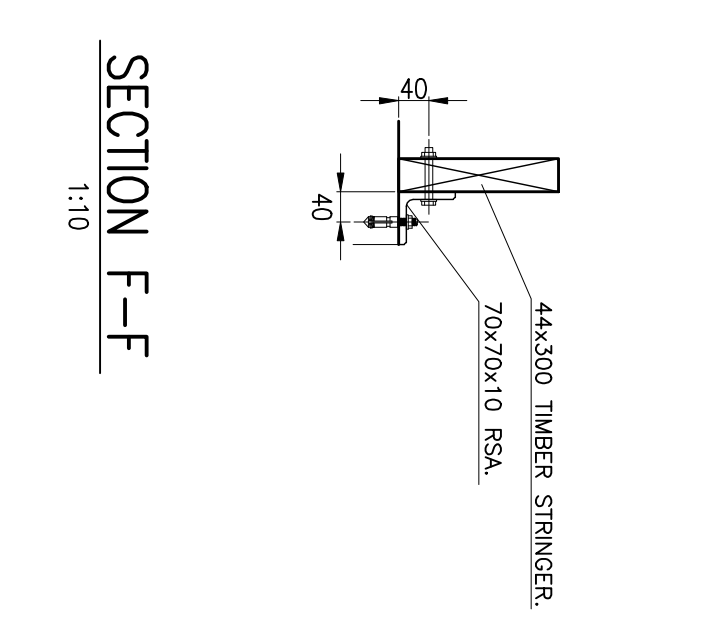


SECTION F-F
1:10

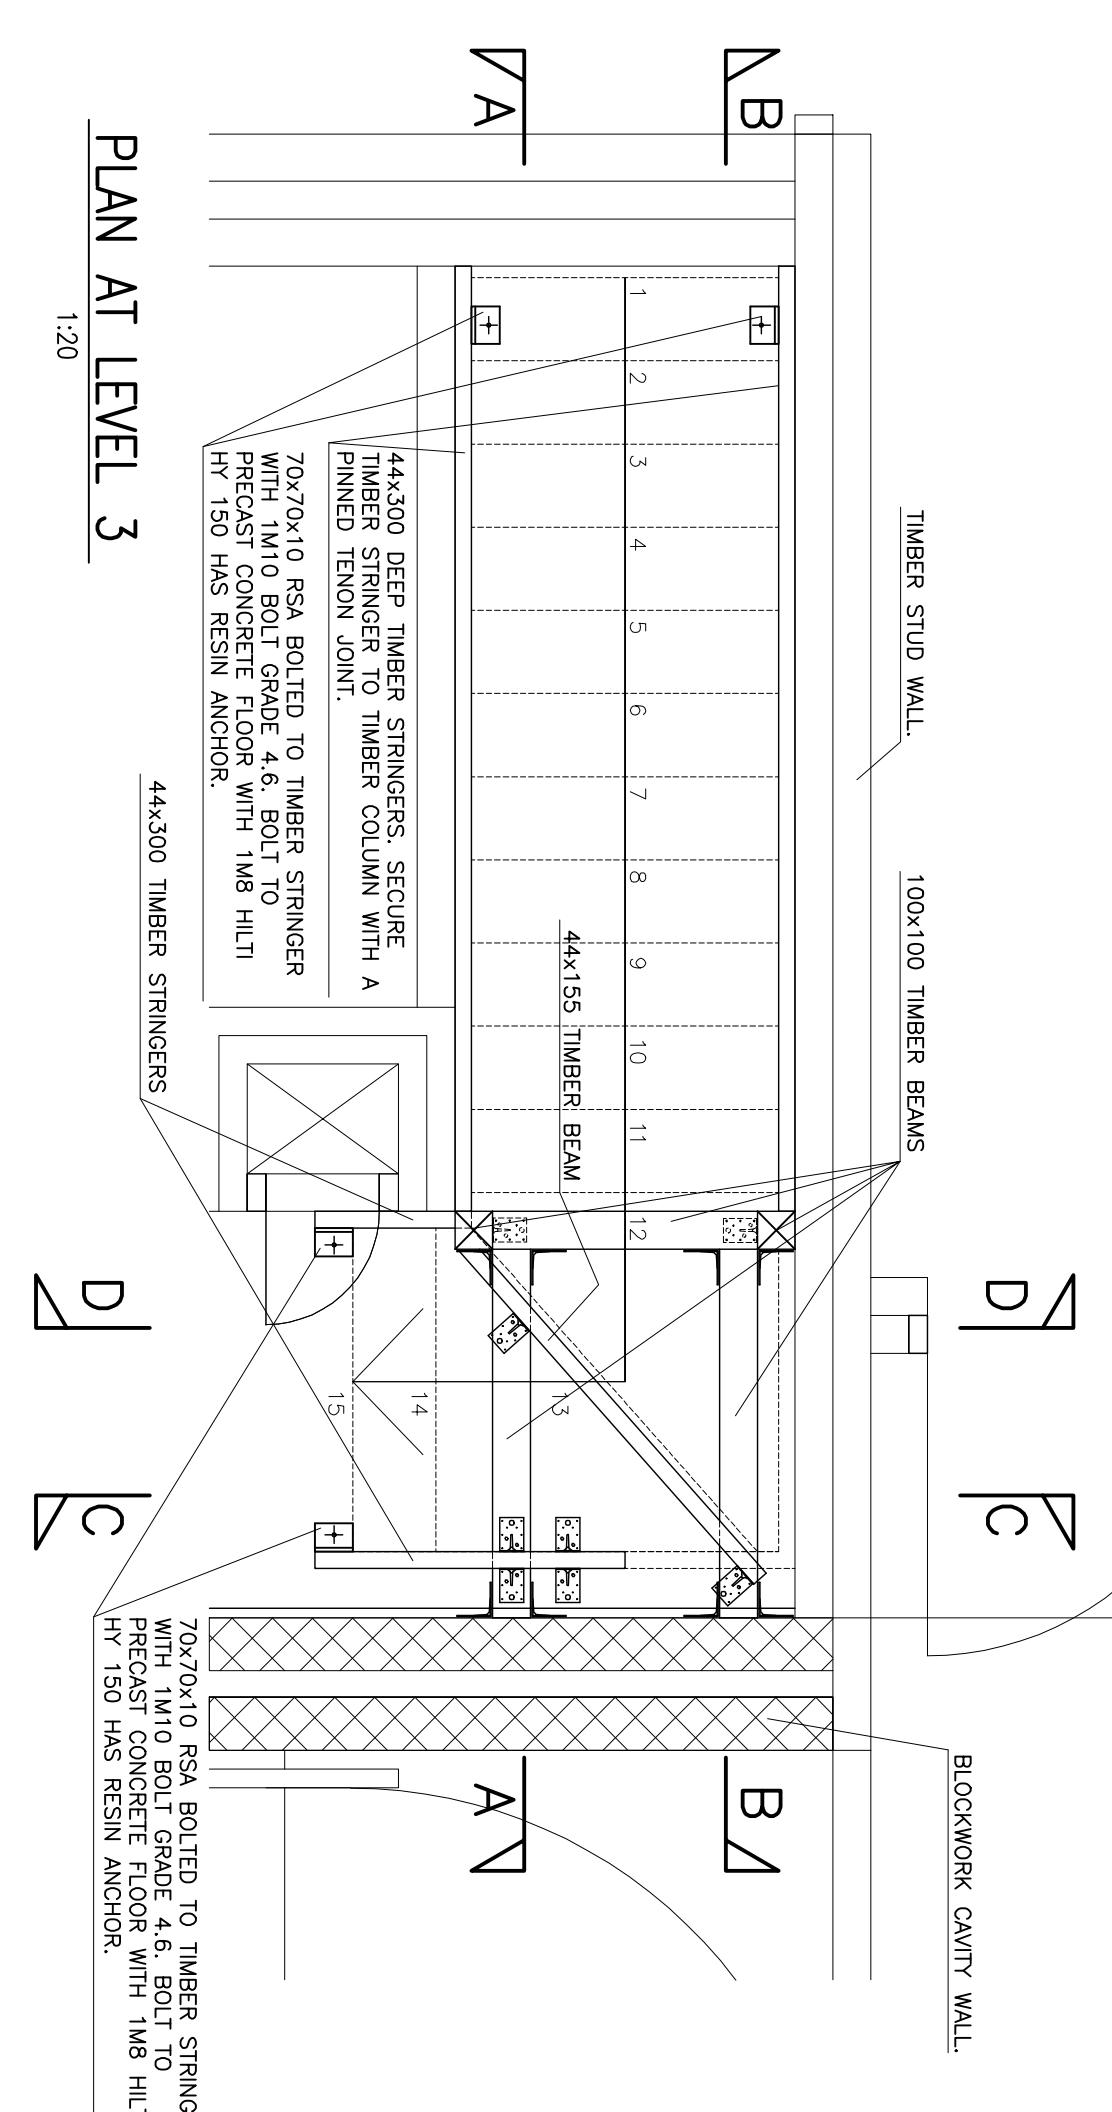

PLAN AT LEVEL 3

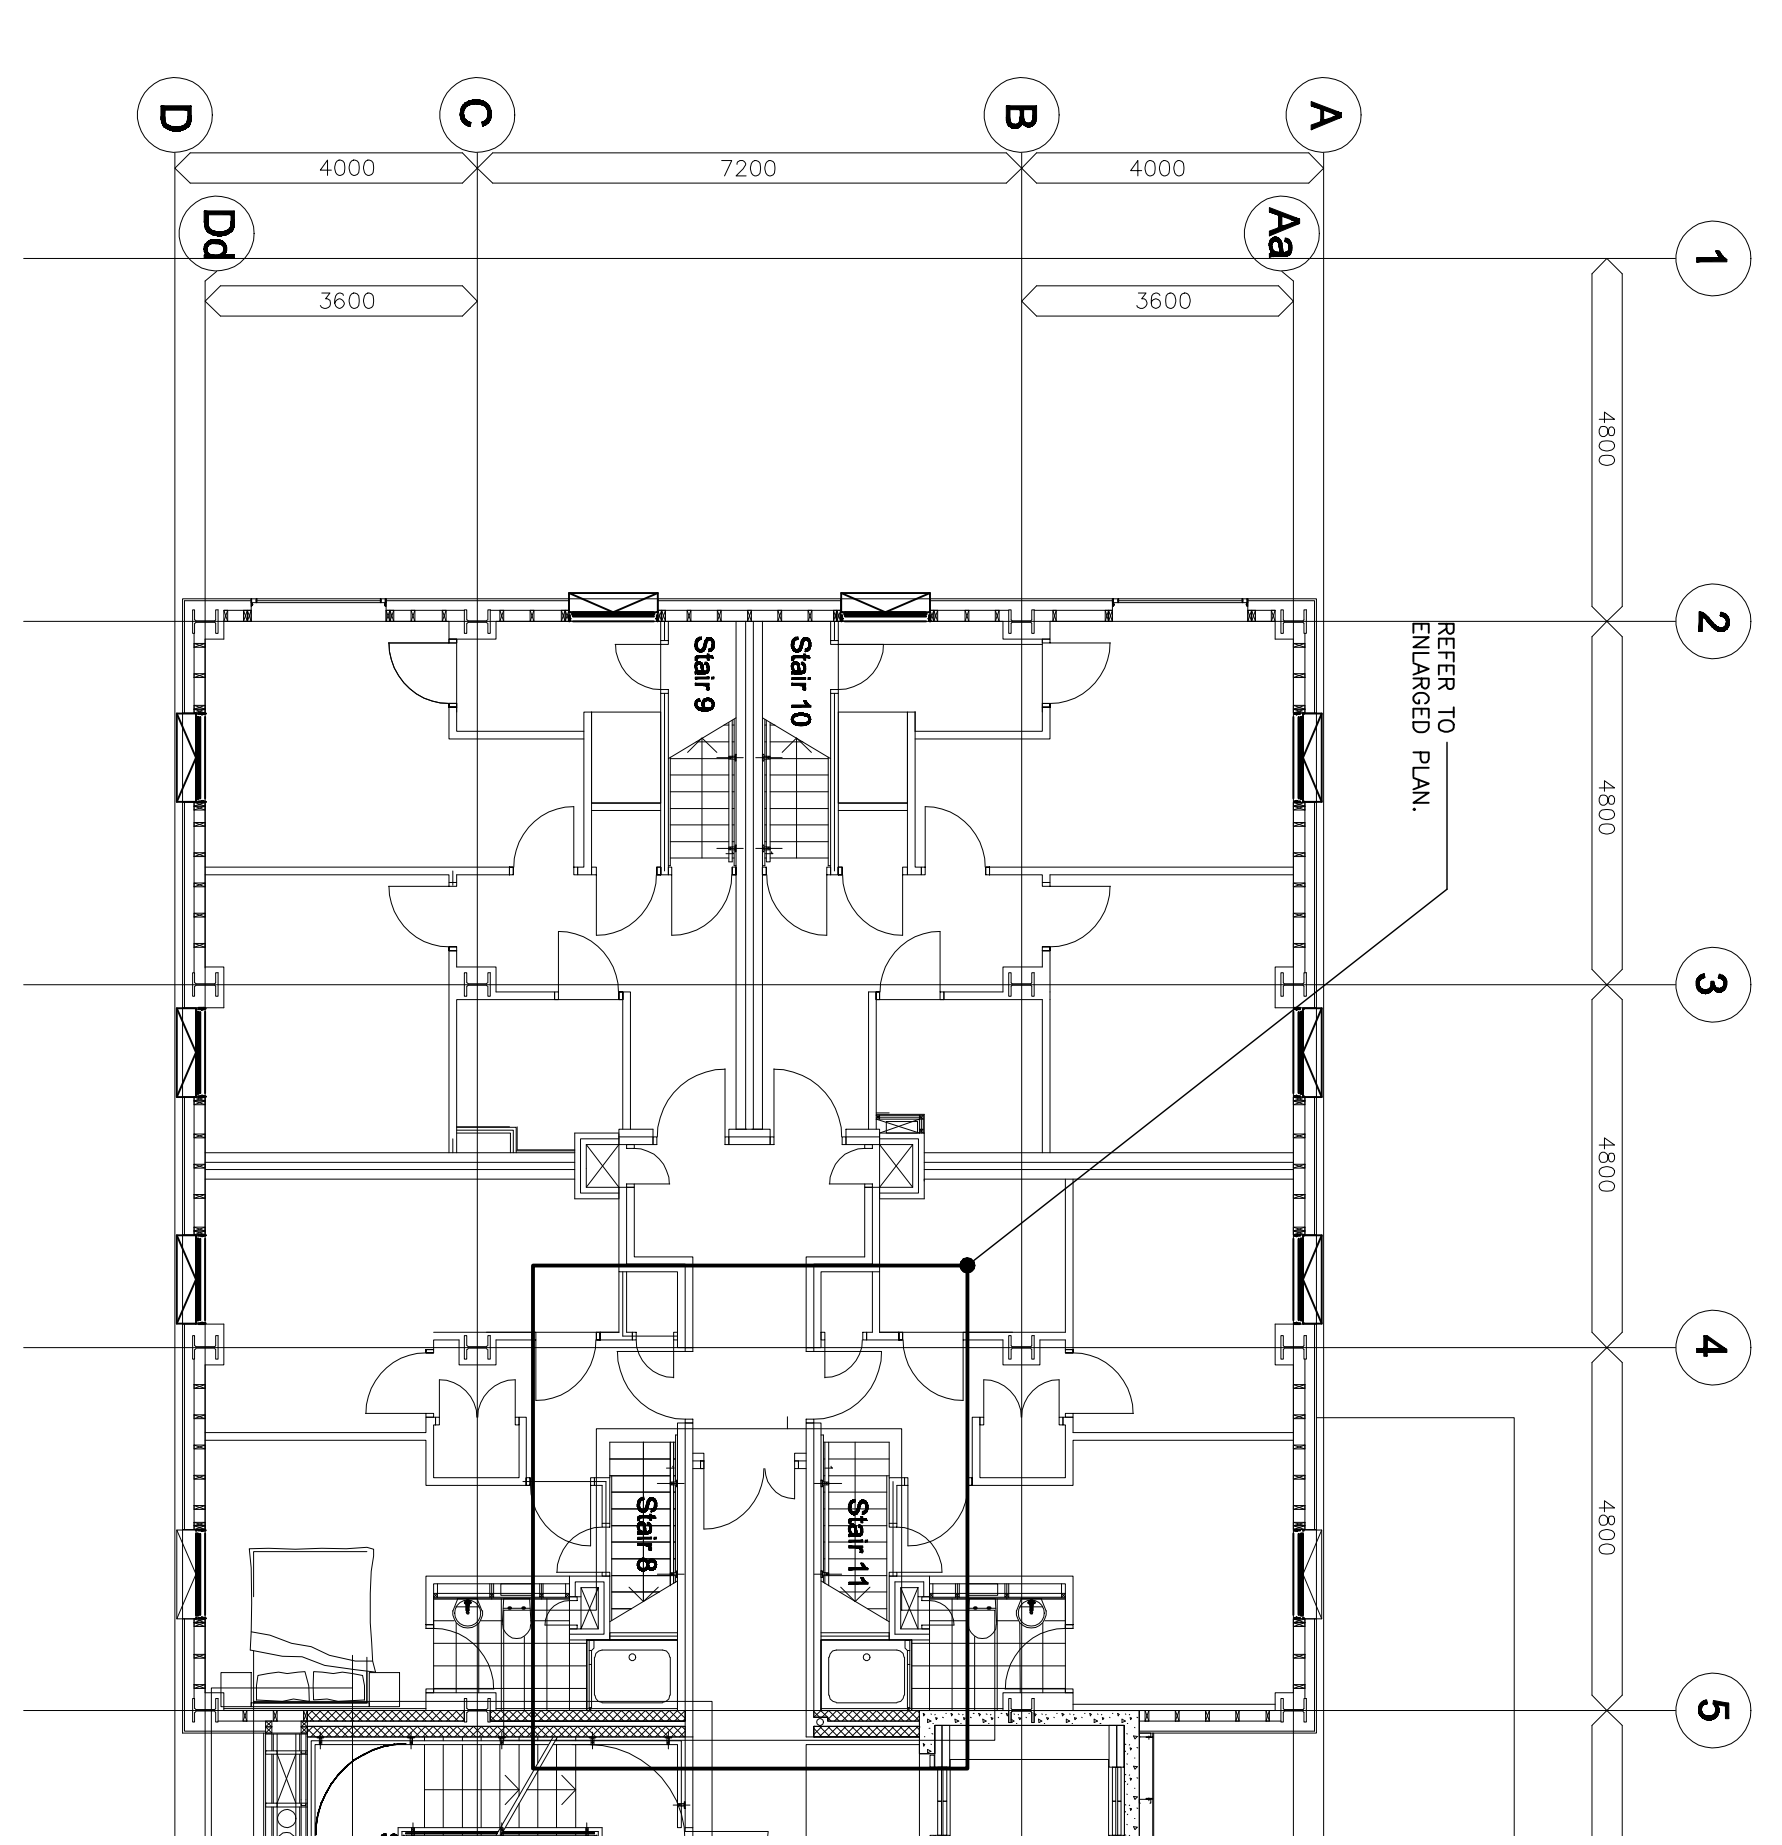PART PLAN ON LEVEL 3
1:100.

STATUS: -		BY: _____	
AS-BUILT		DATE: _____	
DESIGN BY: _____	DATE: _____	CHKD: _____	
PROJECT NUMBER: _____	DWG. NO.: _____		
CLIENT			
[CTP'S] JAMES			
ARCHITECT:			
FaulknerBrowns			
CONTRACT			
WAKKEFIELD WATERFRONT BUILDING 20			
			
SEIC Consulting Engineers Consulting Structural & Civil Engineers Sunderland House, Station Road, Haverhill, Essex S19 6RT Telephone 01703 250000 Fax 01703 250000			
DRAWING TITLE			
INTERNAL STAIRCASE 8 AND 11 G.A. DETAILS			
SIZES: 1:100 1:20 1:10.			
CONTRACT No	DWG. No		
5011180C	20-402		