




PART NORTH ELEVATION.  
1:50.

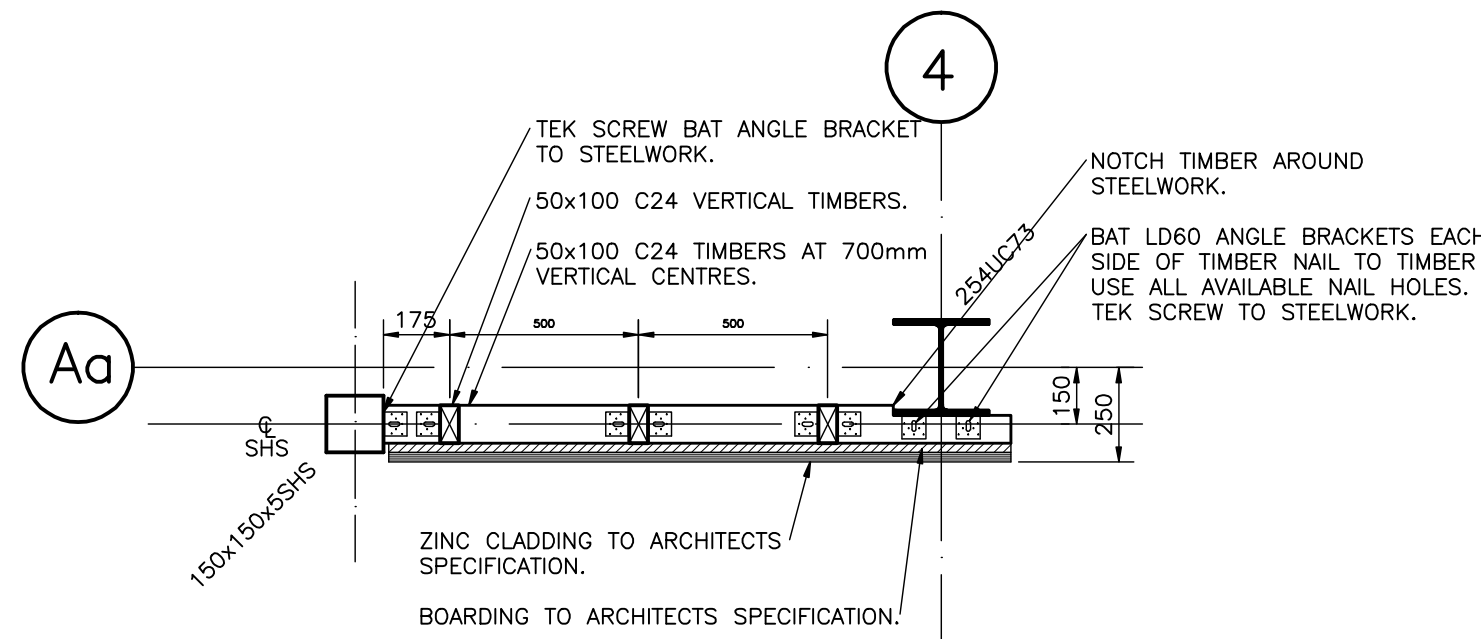


SECTION A-A.  
1:20.

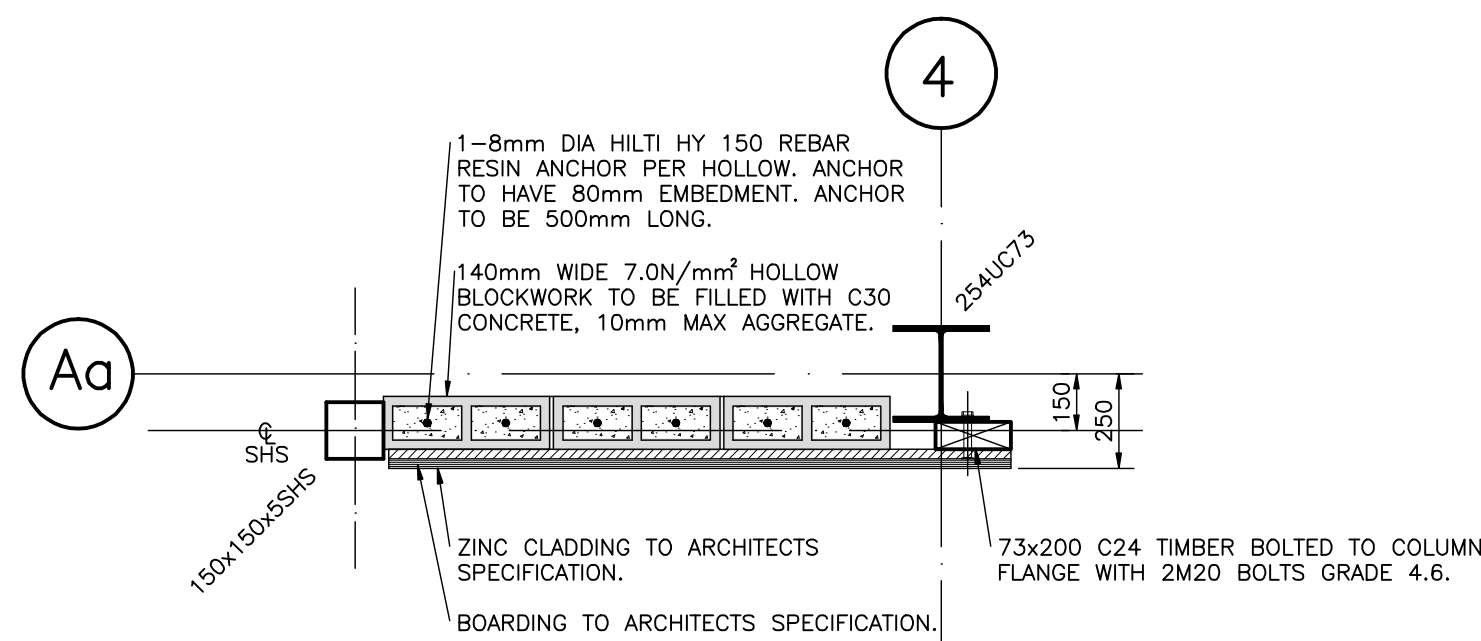


SECTION B-B.  
1:20.

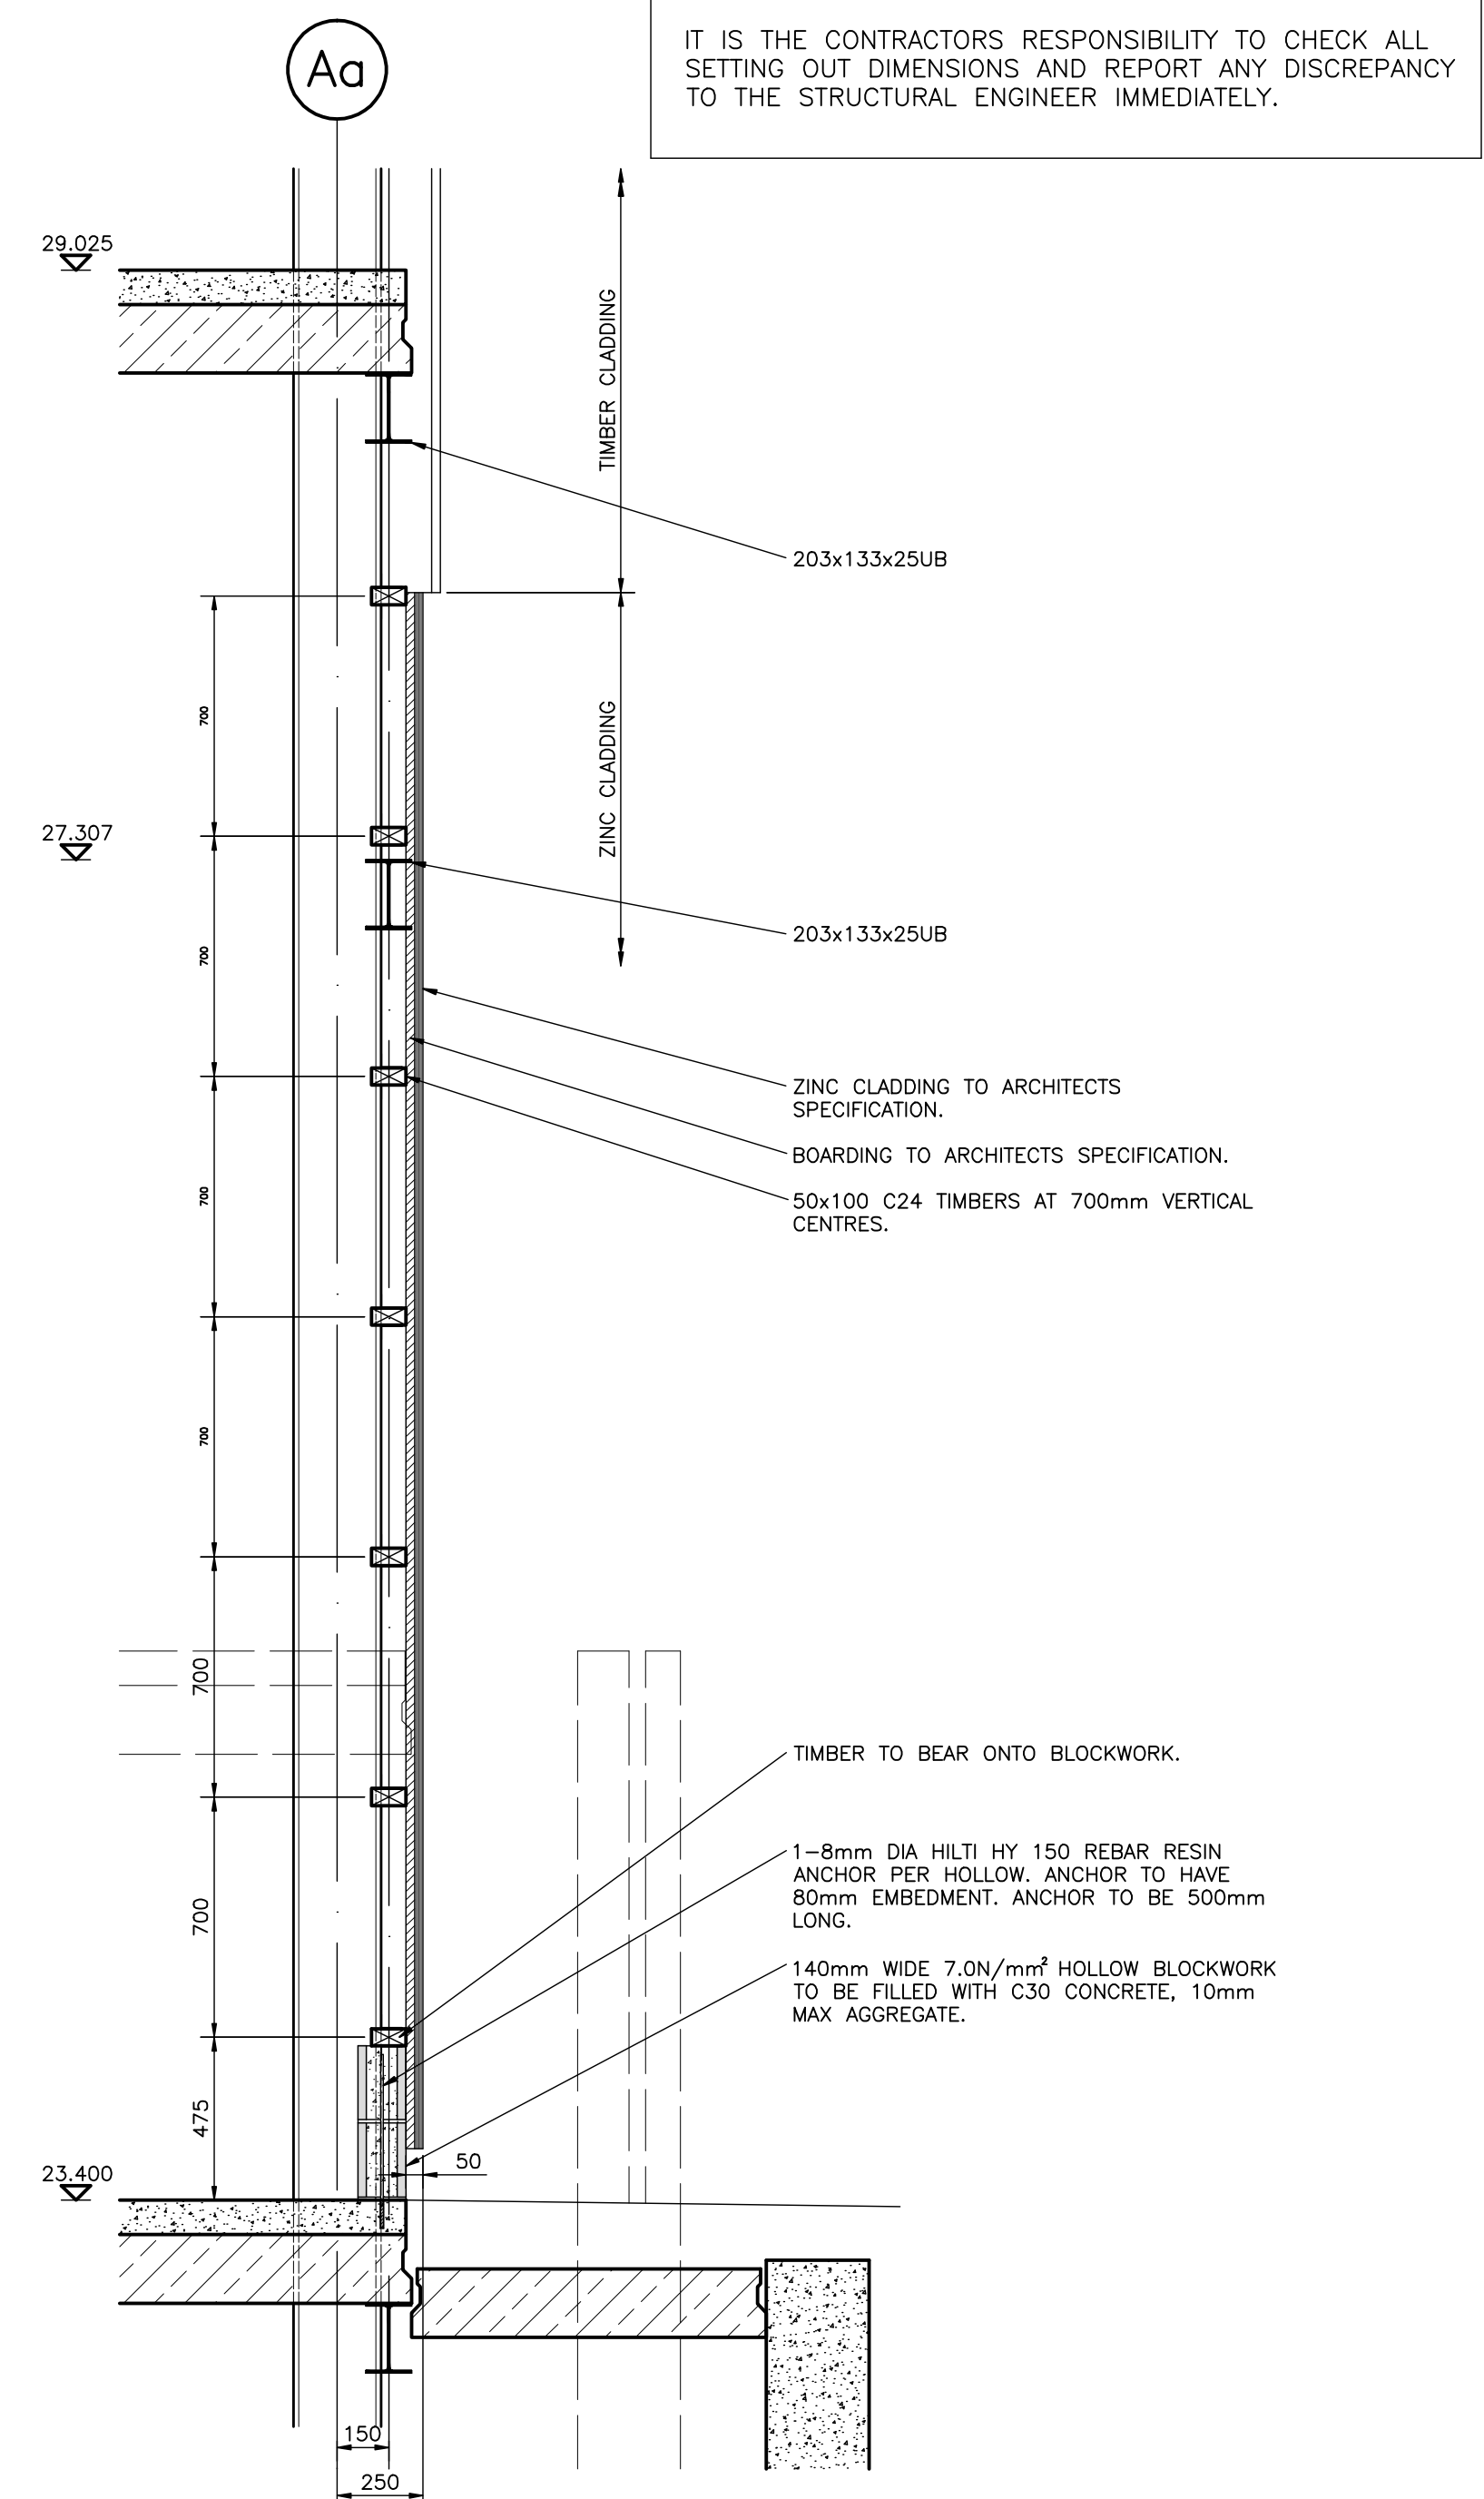


SECTION C-C.  
1:20.

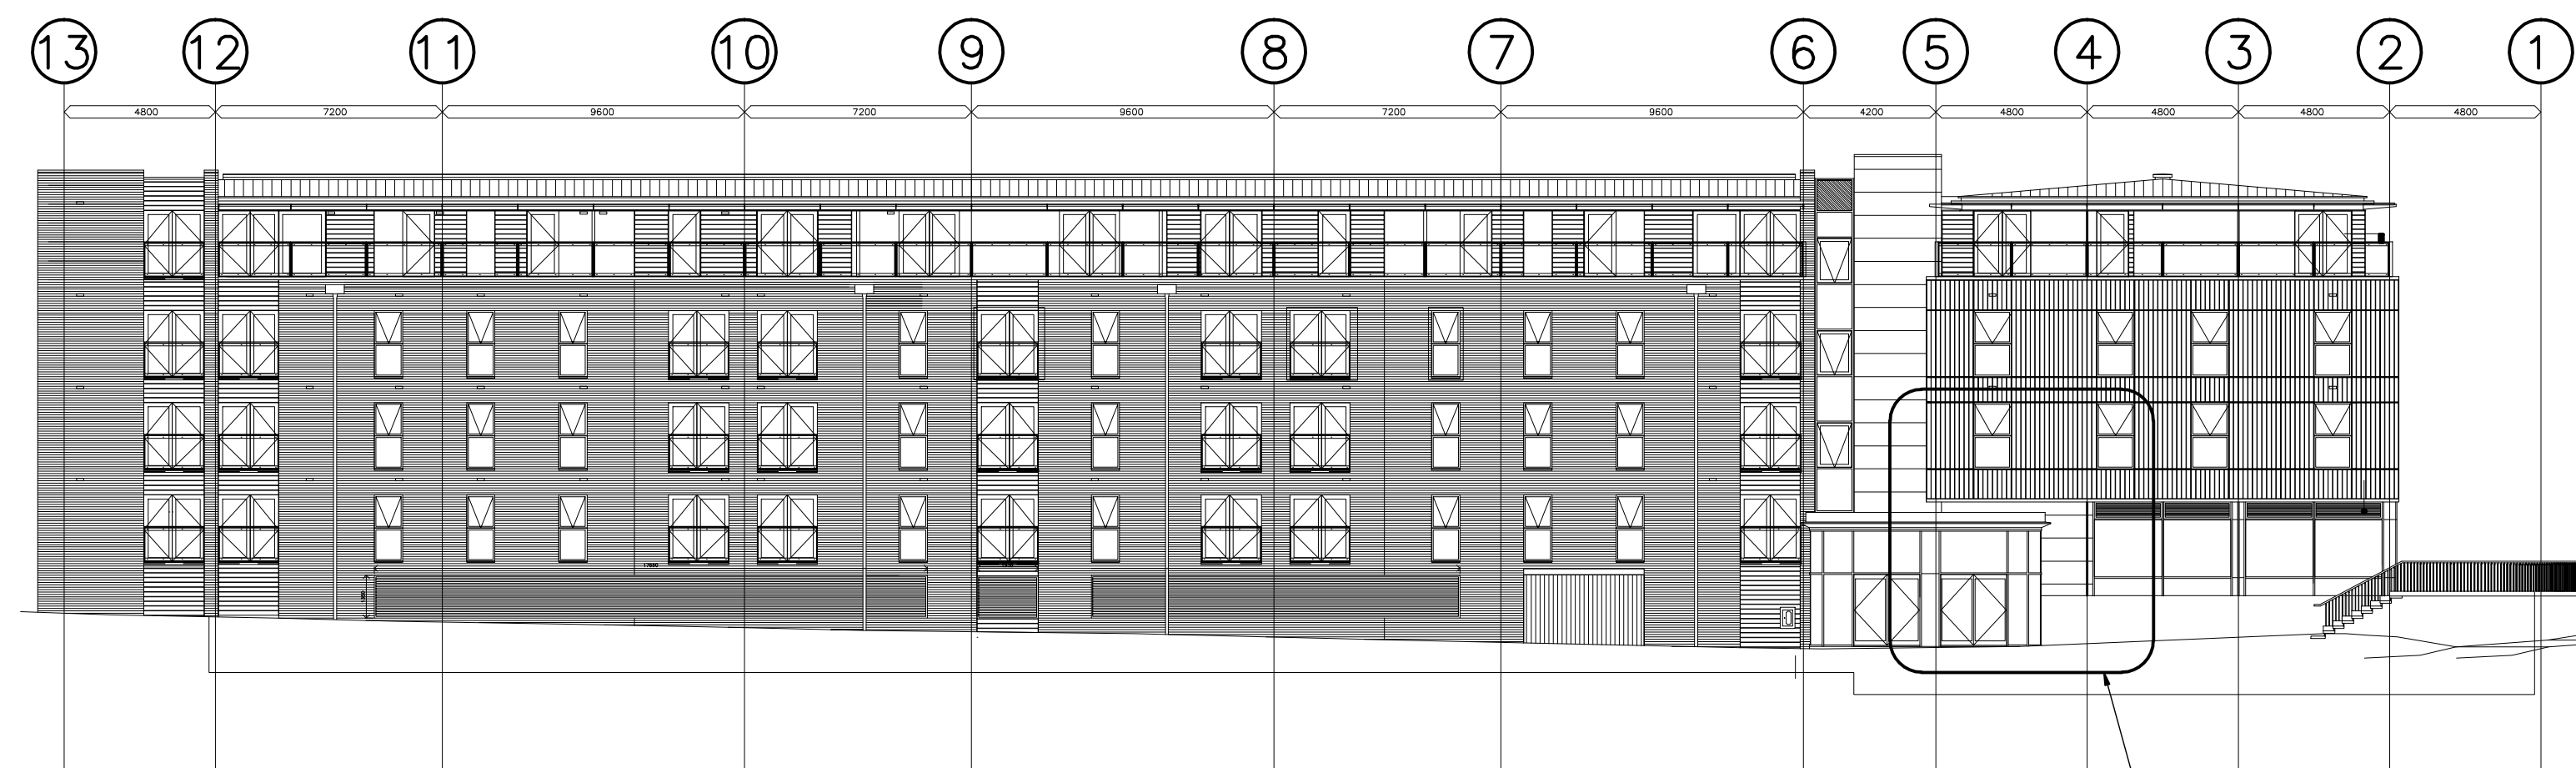

NORTH ELEVATION.  
1:200.

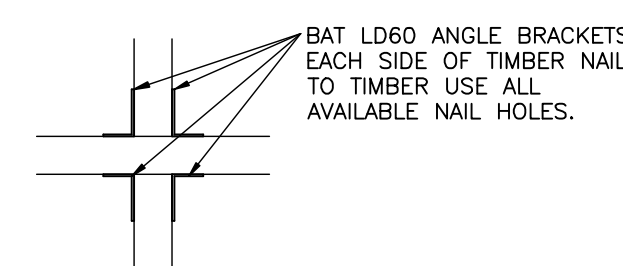

DETAIL 1.  
1:10.

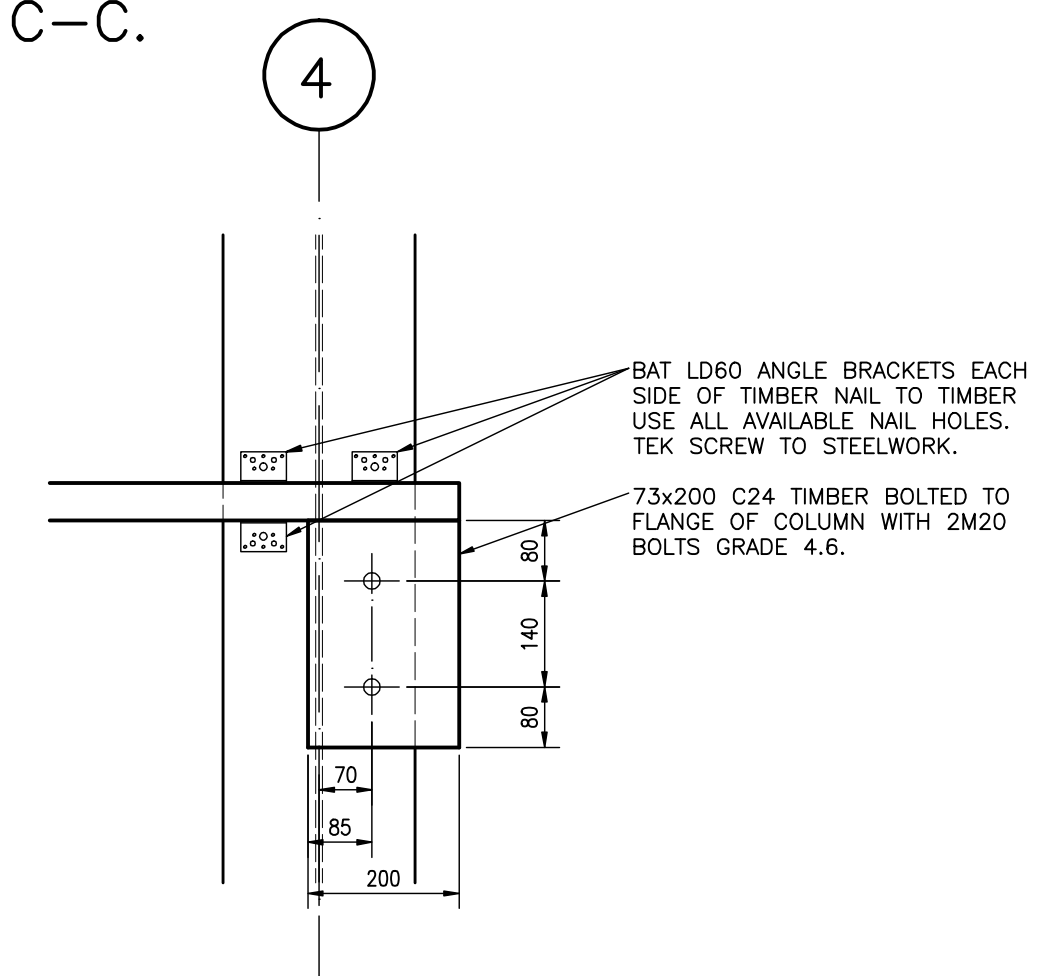

DETAIL 2.  
1:10.

NOTES.

1 THIS DRAWING TO BE READ IN CONJUNCTION WITH ALL RELEVANT ARCHITECTS AND SEJC CONSULTING ENGINEERS DRAWINGS.

MK REVISIONS

BY

DATE

CHK

STATUS:—

AS BUILT

DRAWN BY: CM WAGSTAFF DATE: 23.05.08

CHECKED BY: DATE:

PROJECT ENGINEER: DATE:


CLIENT.

CTP S<sup>r</sup> JAMES

ARCHITECT.

FaulknerBrowns

CONTRACT  
WAKEFIELD WATERFRONT  
BUILDING 20

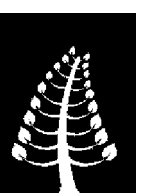

**SEJC Consulting Engineers**  
Consulting Structural & Civil Engineers

Sanderson House, Station Road, Hornforth, Leeds LS18 5NT  
Telephone 0113 2590090 Fax 0113 2599640

DRAWING TITLE  
ZINC CLADDING SUPPORT  
DETAILS TO NORTH  
ELEVATION

SCALES AS SHOWN @ A1

CONTRACT No DRG No

501180C 20-403