

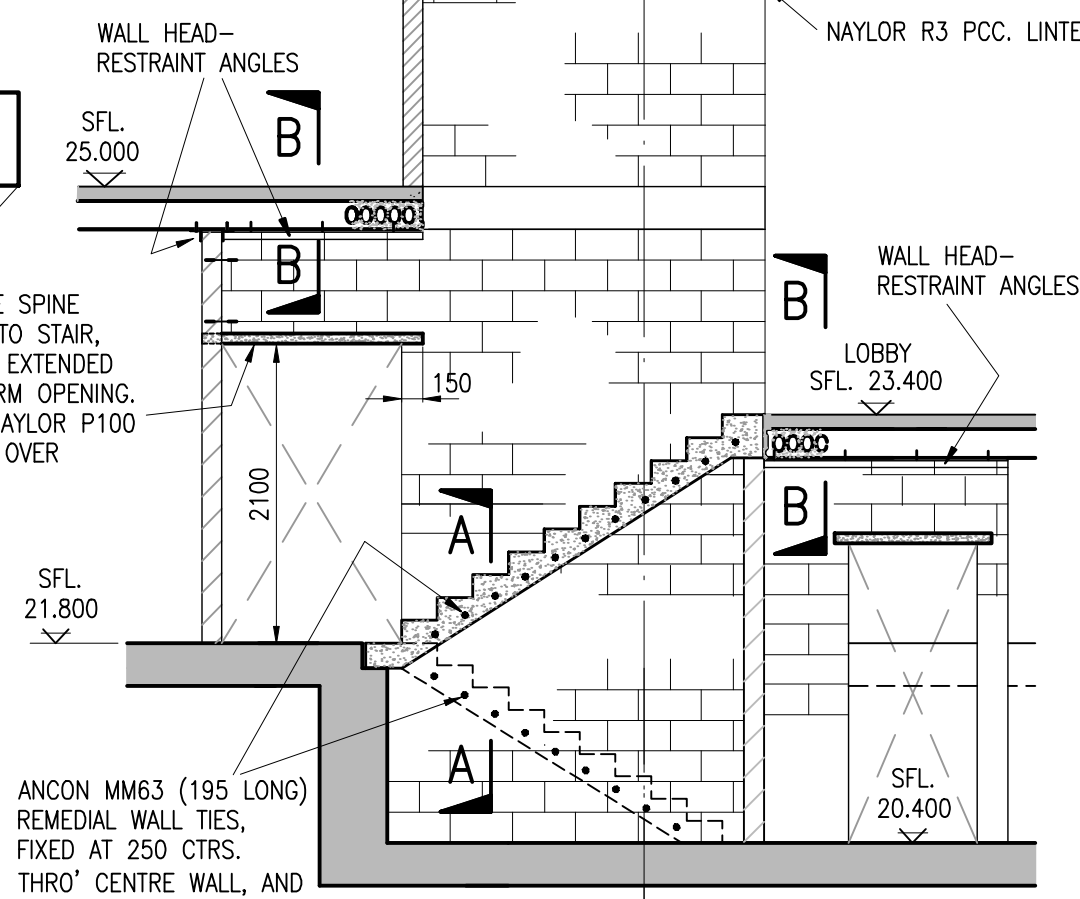


NB. ROOF/FLOOR CONSTRUCTION TO STAIR & WC, DESIGNED FOR A MAX. SUPER IMPOSED LOAD OF 2.5kN/m²

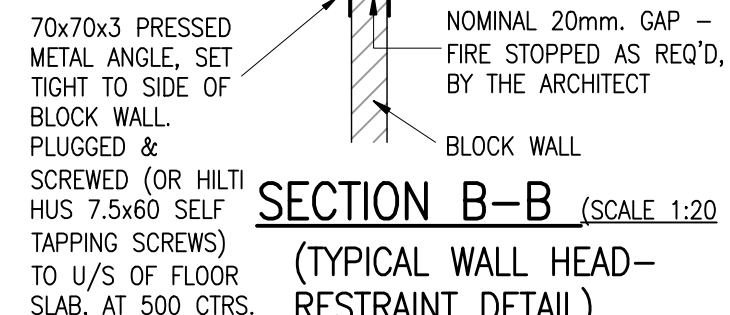

STATUS:—			
AS-BUILT			
DRAWN BY	SH.	DATE	OCT.'07
CHECKED BY	_____	DATE	_____
PROJECT ENGINEER	_____	DATE	_____
CLIENT.			
CTP St JAMES			
ARCHITECT			
FaulknerBrowns			
CONTRACT			
WAKEFIELD WATERFRONT, PHASE 1, BUILDING 20			

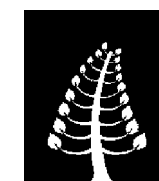

SEJC Consulting Engineers
Consulting Structural & Civil Engineers
Sanderson House, Station Road, Horsforth, Leeds LS18 5NT
Telephone 0113 2590090 Fax 0113 2586640

DRAWING TITLE		MASONRY WALL RESTRAINT DETAILS TO BASEMENT AREA	
SCALES		1:50, 1:20	(@ A3)
CONTRACT No	DRG No	501180C	20-SK07