



**SEJC Consulting Engineers**  
Consulting Structural & Civil Engineers

Sanderson House, Station Road, Horsforth, Leeds LS18 5NT  
Telephone 0113 2590080 Fax 0113 2590040

PROJECT

**WAKEFIELD WATERFRONT,  
PHASE 1,  
BUILDING 20**

JOB REF No

**501180C**

SHEET No

**SK09**

MADE BY

**SH.**

CHECKED BY

DATE


**DEC.'07**

CLIENT

**CTP S<sup>t</sup> JAMES**

**AS-BUILT**

UPSTANDS SET OUT AS PER  
ARCHITECT'S DETAILS

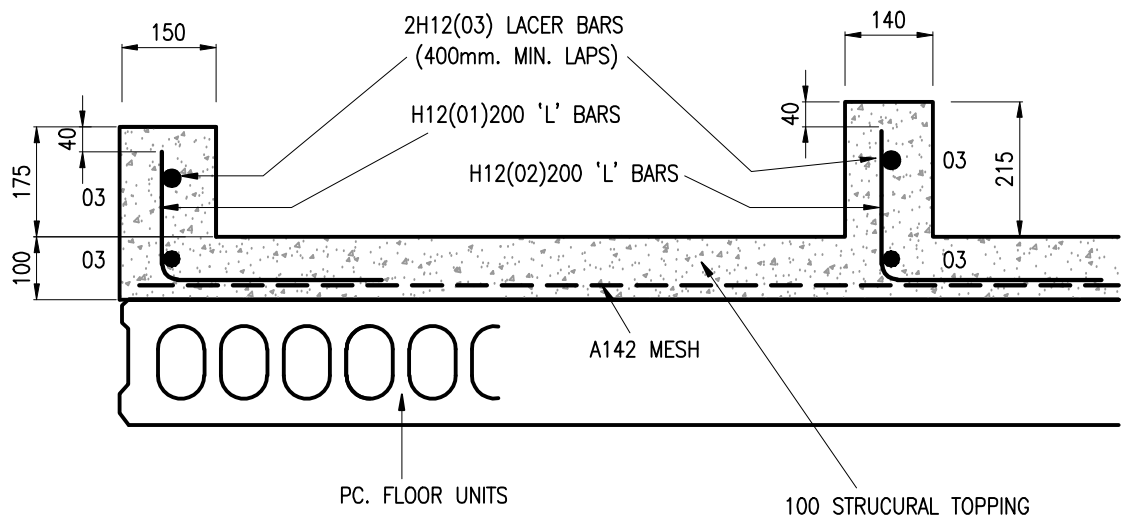

**TYPICAL REINFORCEMENT DETAILS  
FOR RC. UPSTANDS AT LEVEL 4.**

1:10