


SECTION A-A  
1:25

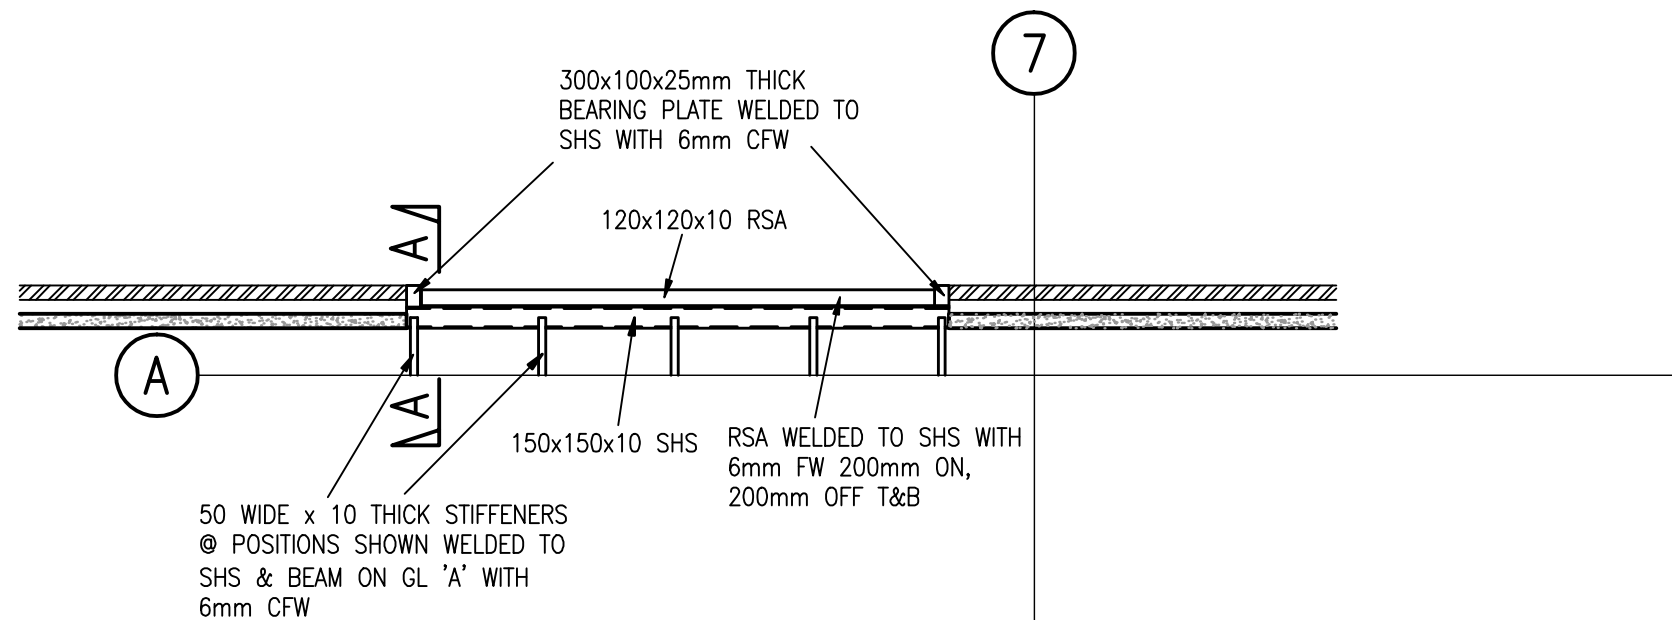

BRICKWORK SUPPORT  
1:50

CONTRACTOR TO SITE MEASURE  
PRIOR TO FABRICATION

STATUS:—  
AS-BUILT

DRAWN BY\_ \_ \_ \_ \_ JL \_ \_ \_ \_ DATE\_ 21.12.07 \_  
CHECKED BY\_ \_ \_ \_ \_ CMW \_ \_ \_ \_ DATE\_ 21.12.07 \_  
PROJECT ENGINEER\_ \_ \_ \_ \_ DATE\_ \_ \_ \_ \_

CLIENT.


CTP St JAMES

ARCHITECT

FAULKNER BROWNS

CONTRACT

WAKEFIELD WATERFRONT  
BUILDING 20

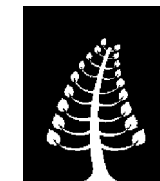

**SEJC Consulting Engineers**  
Consulting Structural & Civil Engineers

Sanderson House, Station Road, Horsforth, Leeds LS18 5NT  
Telephone 0113 2590090 Fax 0113 2596640

DRAWING TITLE

BRICKWORK SUPPORT  
DETAIL — CAR PARK  
ENTRANCE

SCALES 1:50 1:25

CONTRACT No 501180C  
DRG No SK10

