



SEJC Consulting Engineers
Consulting Structural & Civil Engineers

Sanderson House, Station Road, Horsforth, Leeds LS18 5NT
Telephone 0113 2580060 Fax 0113 2580640

PROJECT

**WAKEFIELD WATERFRONT,
PHASE 1,
BUILDING 20**

CLIENT

CTP St JAMES

JOB REF No

501180C

SHEET No

SK11

MADE BY


SH.

CHECKED BY


DATE

JAN.'08

AS-BUILT

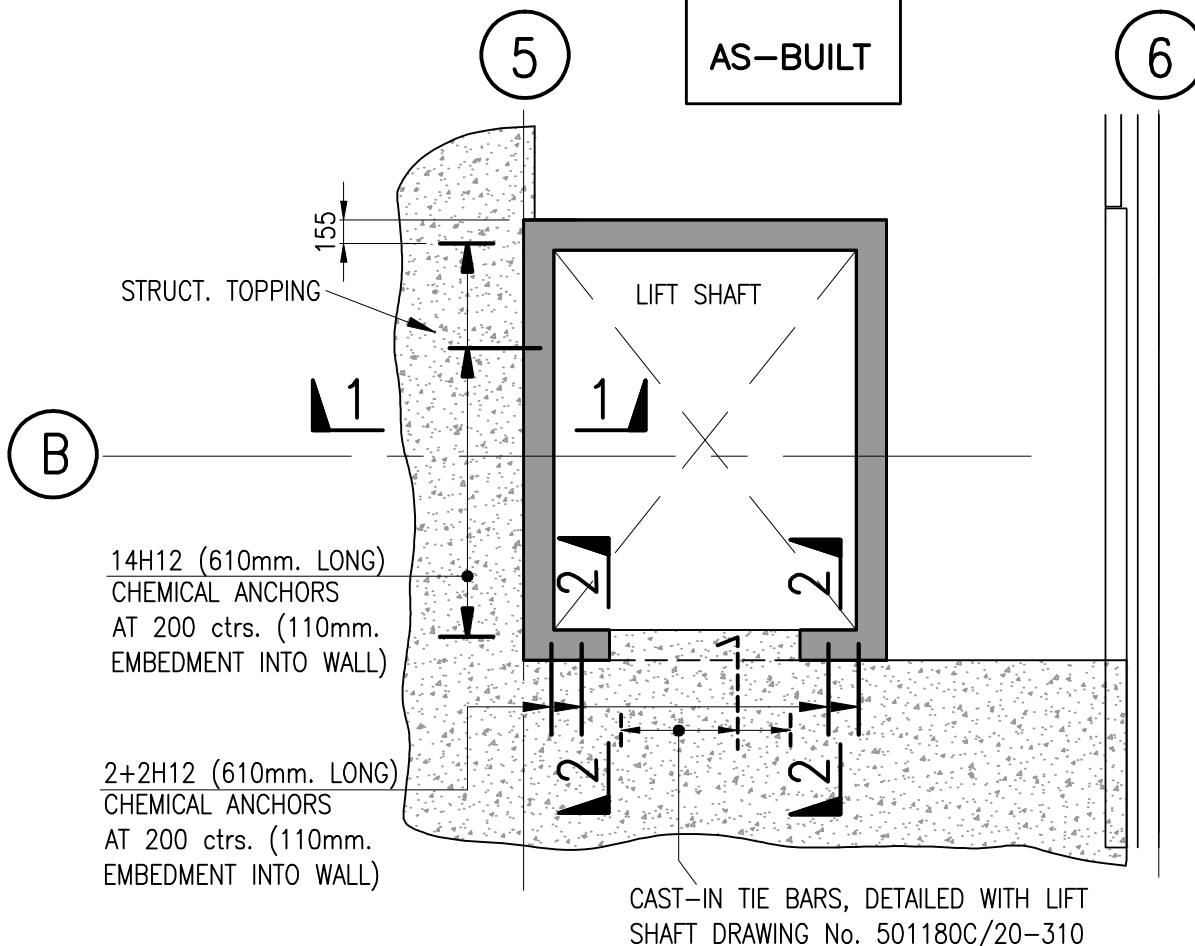


**PLAN INDICATING TIE-BAR REINF'T DETAILS, BETWEEN LIFT
SHAFT AND CONCRETE TOPPING (LEVELS 1,2,3 & 4)** 1:50

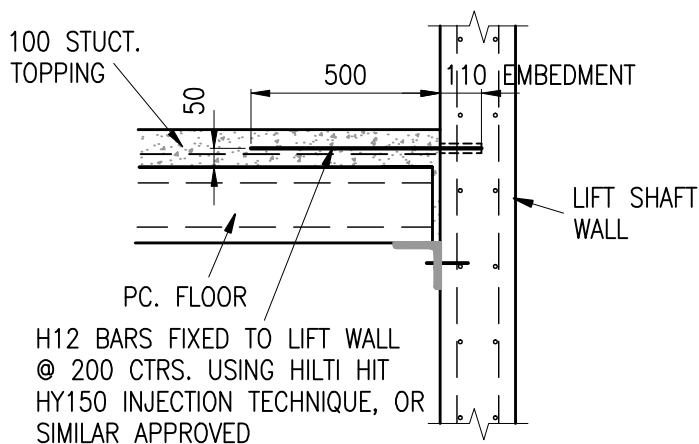

SECTION 1-1

1:20

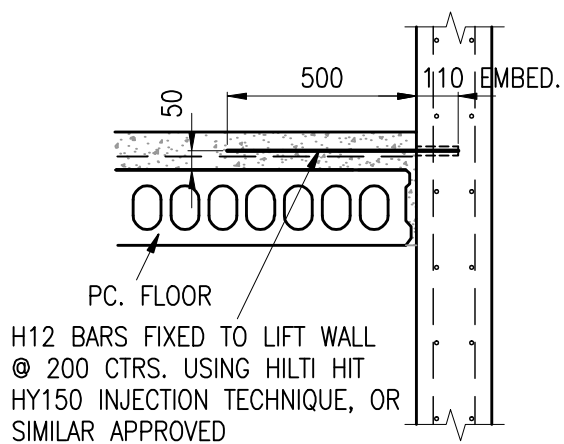

SECTION 2-2

1:20