


STATUS:—		AS-BUILT	
DRAWN BY	SH.	DATE	JAN.'08
CHECKED BY	---	DATE	---
PROJECT ENGINEER	---	DATE	---
CLIENT.			
CTP St JAMES			
ARCHITECT			
FaulknerBrowns			
CONTRACT			
WAKEFIELD WATERFRONT, PHASE 1, BUILDING 20			

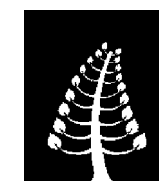

**SEJC Consulting Engineers**  
Consulting Structural & Civil Engineers

Sanderson House, Station Road, Horsforth, Leeds LS18 5NT  
Telephone 0113 2590090 Fax 0113 2590040

DRAWING TITLE		EXTERNAL GROUND SLAB TO ENTRANCE LOBBY	
SCALES		1:50, 1:20 (@ A3)	
CONTRACT No	DRG No		
501180C	20-SK12		