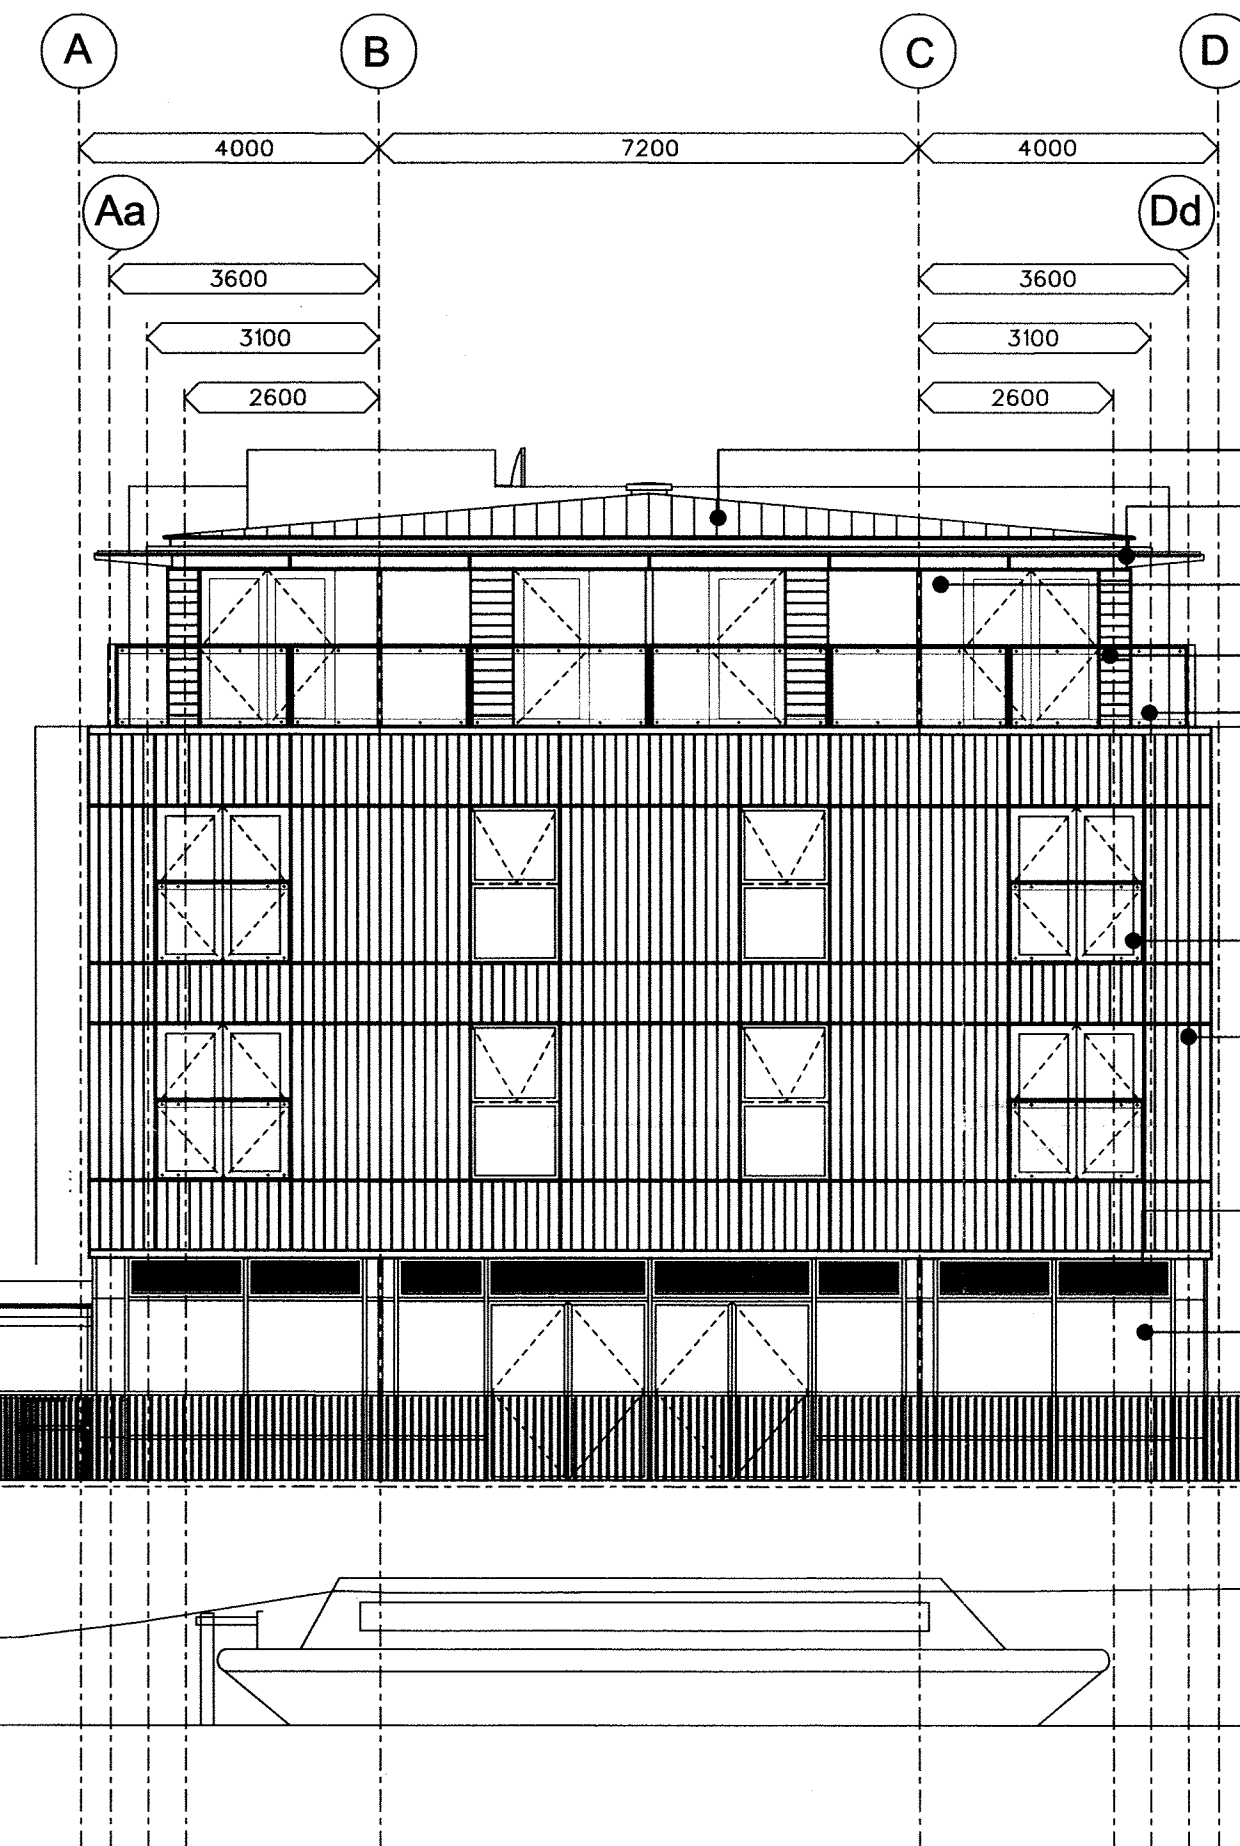


WEST ELEVATION

DATUM 20.0M

FLOOD LEVEL 24.9M

RESIDENTIAL AND RESTAURANT
ENTRANCEASHLAR FACED FLOOD DEFENCE
AND RESTAURANT TERRACE

KALZIP 305 STANDING SEAM ROOF

BRISE SOLEIL SUNSHADING

LIGHT GREY RENDER

TIMBER RAINSCREEN CLADDING

WIRE BALLUSTRADE SYSTEM

GLASS BALLUSTRADE

TIMBER RAINSCREEN CLADDING

CURTAIN WALLING SYSTEM WITH INTEGRATED
VENTILATION LOUVRECURTAIN WALLING SYSTEM WITH SOLAR
CONTROL GLASS

Rev		Date	Drawn	Checked	Rev	Date	Drawn	Checked	Rev	Date	Drawn	Checked	Drawing Status		Job No.	Drawing No.	Rev
02.09.05		ISSUED FOR PLANNING			16.06.06		REV C - ISSUED FOR TENDER			16.06.06		AS BUILT			1864	AL20(0) 73	H
A	01.11.05	BALLUSTRADE AMMENDED, ENTRANCE CANOPY (BEYOND) INDICATED, PLINTH PROFILE AMMENDED.		RW	BS	D	10.07.06	NBS TEXT EDIT		WTC	RW	Job Title		WAKEFIELD WATERFRONT PHASE 1A			
01.11.05		REV A - ISSUED FOR PLANNING			RW	BS	E	24.01.07	DETAIL REFERENCE OMITTED, RWP'S ADDED		DP	RW	Drawing Title		RESIDENTIAL BLOCK 20 WEST ELEVATION		
B	07.06.06	DOOR AND WINDOW FRAMES AMMENDED, BALCONIES UPDATED, TIMBER CLADDING AMMENDED, EXTERNAL BALLUSTRADES AMMENDED, ROOF LINE AMMENDED, CURTAIN WALLING AND VENTILATION TO RESTAURANT AMMENDED.		ESJ	RW	F	07.05.07	GRIDS ADDED, WIRE BALUSTRADING OMITTED AND REPLACED WITH GLASS BALUSTRADE.		NE	RW	Date		16.06.06	Scale	1:100@A1	
07.06.06		REV B - ISSUED FOR TENDER			ESJ	RW	G	11.06.07	OPENINGS AND VEFAC DOUBLE DOOR SIZES REVISED.		NBr	RW	Drawn		ESJ	Checked	RW
C	15.06.06	ROOF LINE AMMENDED, DOORS IN RESTAURANT CURTAIN WALLING ALTERED.		ESJ	RW	H	08.09.08	AS BUILT ISSUE		NBr	RW	Date		16.06.06	Scale	1:100@A1	
15.06.06		REV C - ISSUED FOR TENDER			ESJ	RW					Drawn		ESJ	Checked	RW	Faulkner Browns Architects Dobson House Northumbria Way Killingworth Newcastle upon Tyne NE12 6QW Telephone 0191 268 3007 Fax 0191 268 5227	