


ANY/ALL SITE WELDING TO L.COOPER STEEL STRUCTURE
MUST BE DONE USING LOW HYDROGEN WELDING RODS
(SUITABLY DRIED IN AN OVEN) OR SIMILAR

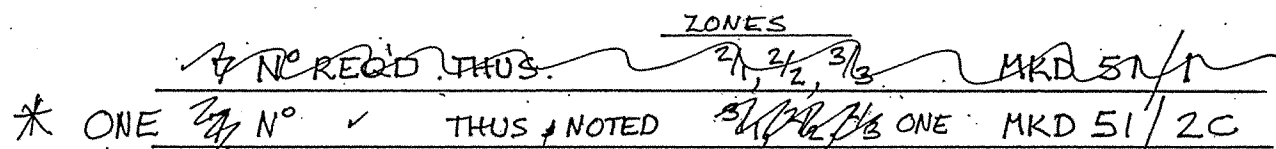

PRG No: 07/18/SW4

