


ANY/ALL SITE WELDING TO L.COOPER STEEL STRUCTURE
MUST BE DONE USING LOW HYDROGEN WELDING RODS
(SUITABLY DRIED IN AN OVEN) OR SIMILAR

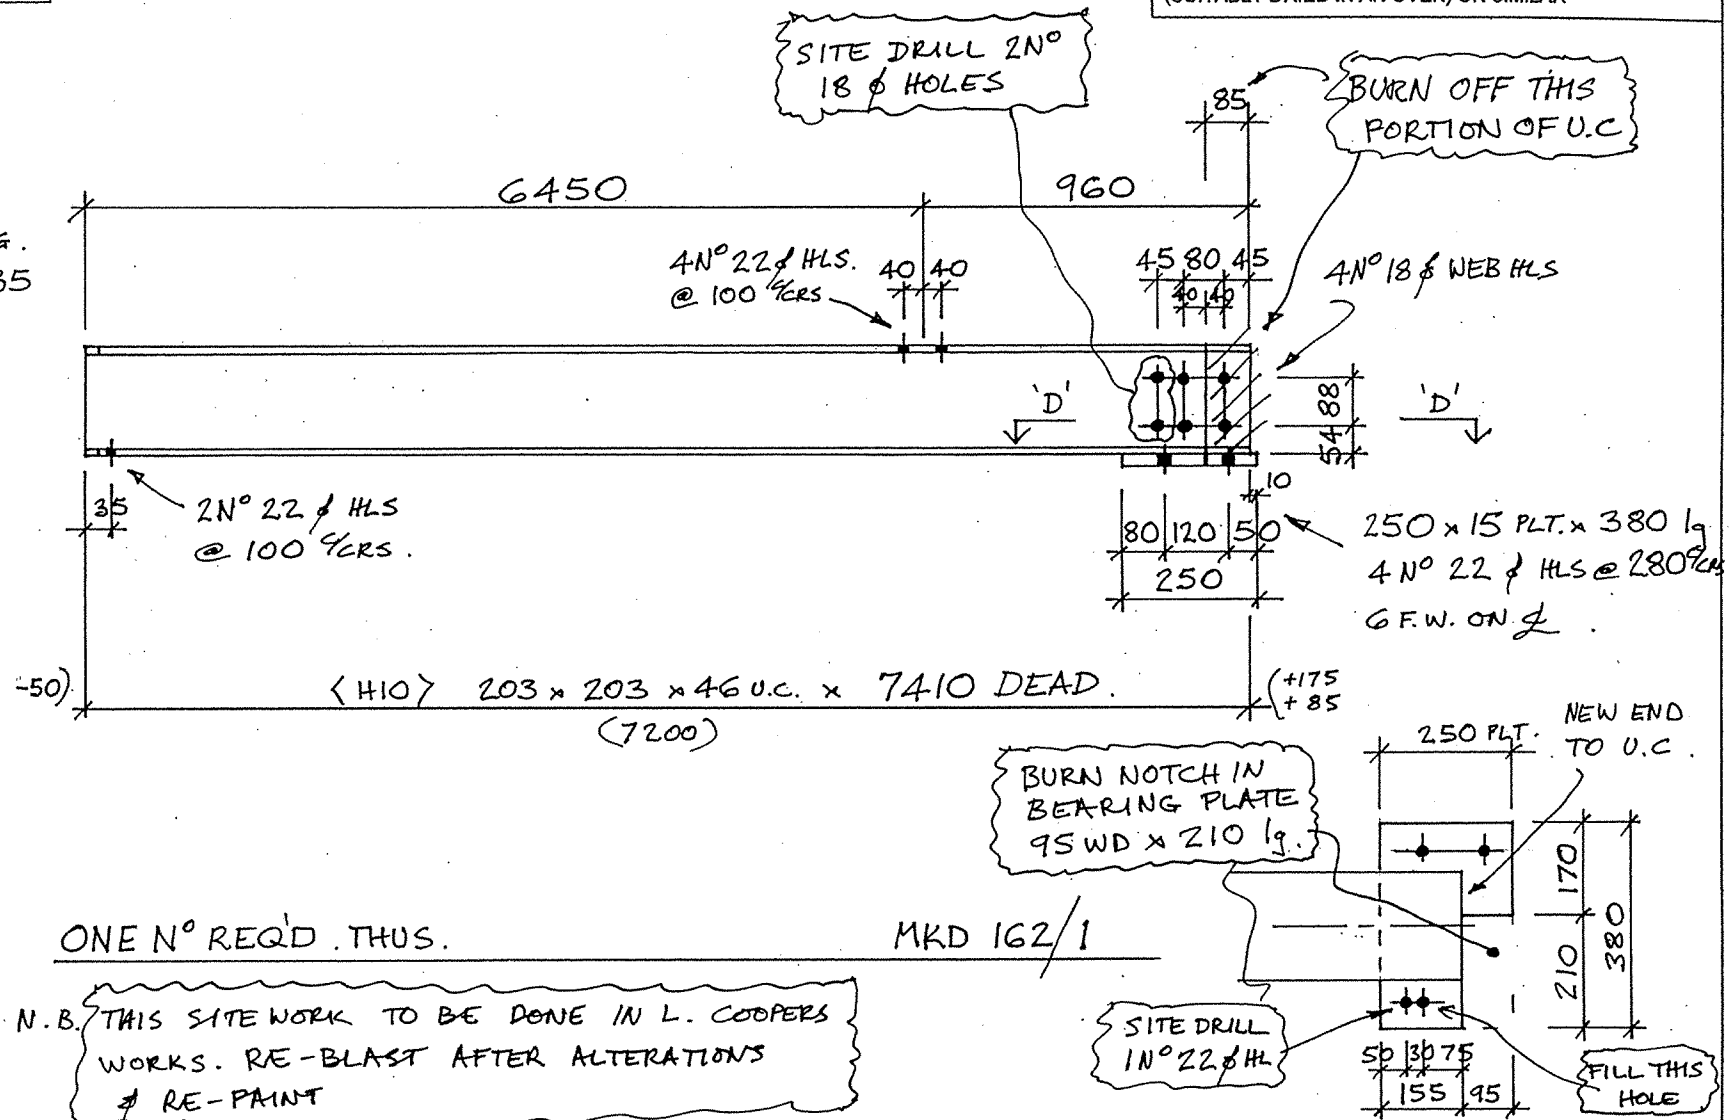

MKD 162/1

N.B. THIS SITE WORK TO BE DONE IN L. COOPERS WORKS. RE-BLAST AFTER ALTERATIONS & RE-PAINT

DRG No: 07/18/SW15

