


ANY/ALL SITE WELDING TO LCOOPER STEEL STRUCTURE  
MUST BE DONE USING LOW HYDROGEN WELDING RODS  
(SUITABLY DRIED IN AN OVEN) OR SIMILAR

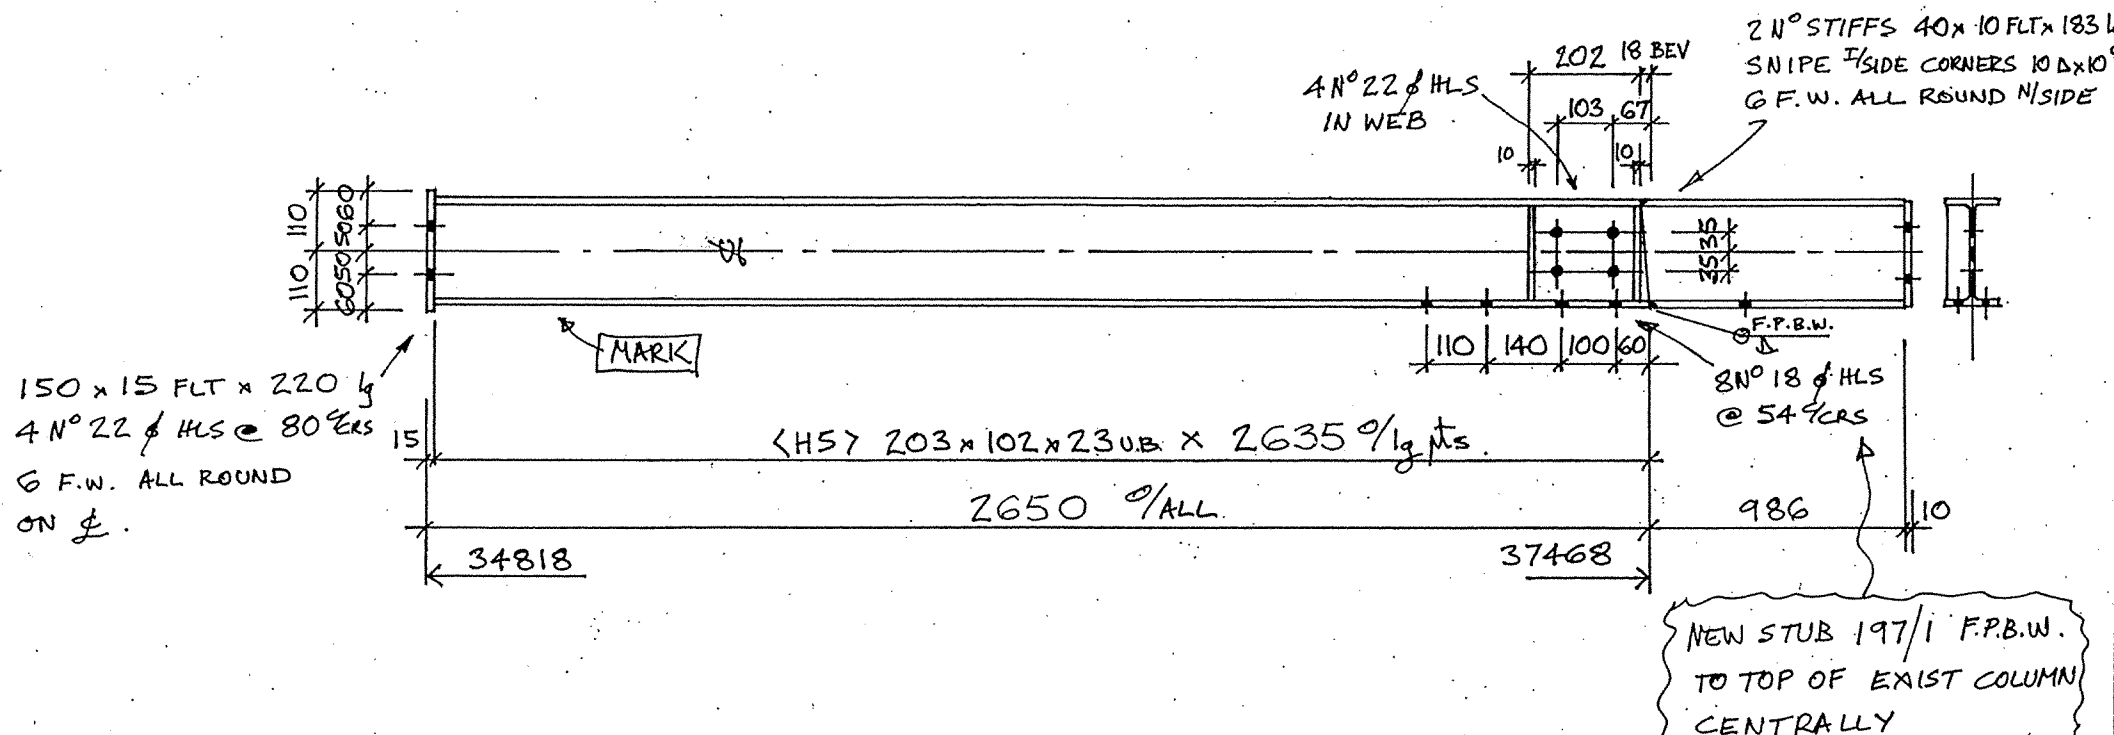

ONE N° REQ'D. THUS.

MKD 145/1

N.B. THIS SITEWORK TO BE DONE IN L. COOPERS WORKS. RE-BLAST AFTER ALTERATIONS  
 & RE-PAINT

TITLE		COLUMNS.
RELEASED FOR	SIGNED:	
FABRICATION/ERECTION	DATE:	
SCALE:		
DRAWN BY: <i>WJG</i>		
CHECK'D BY: <i>TSM</i>	DRG No: <i>07/18/SWB</i>	

NEW STUB 197/1 F.P.B.W.  
TO TOP OF EXIST COLUMN  
CENTRALLY