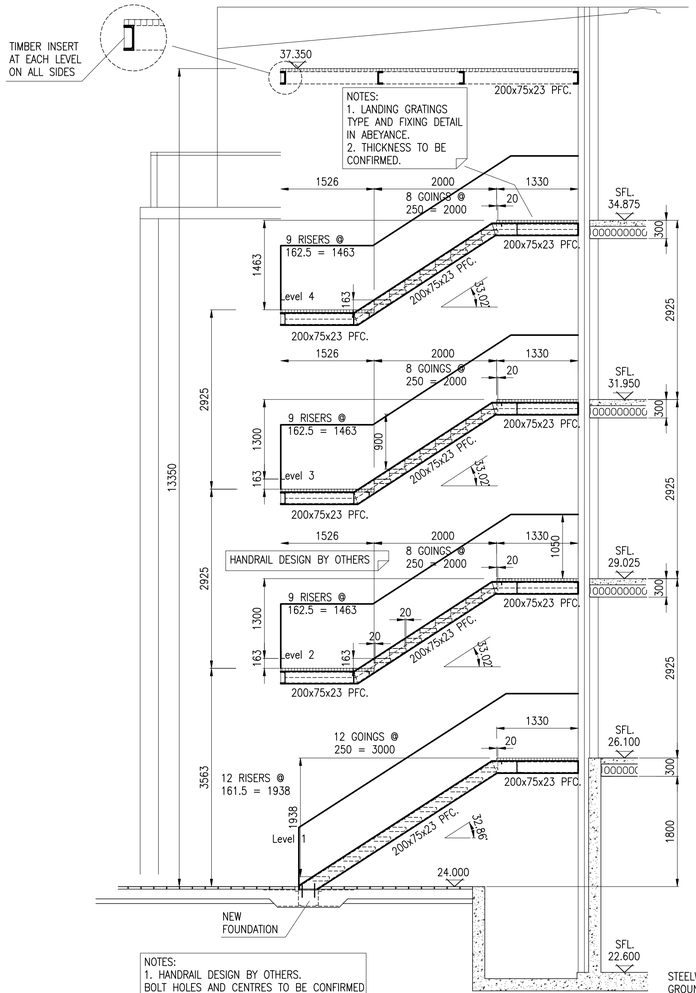

SECTION 1–1
1:50

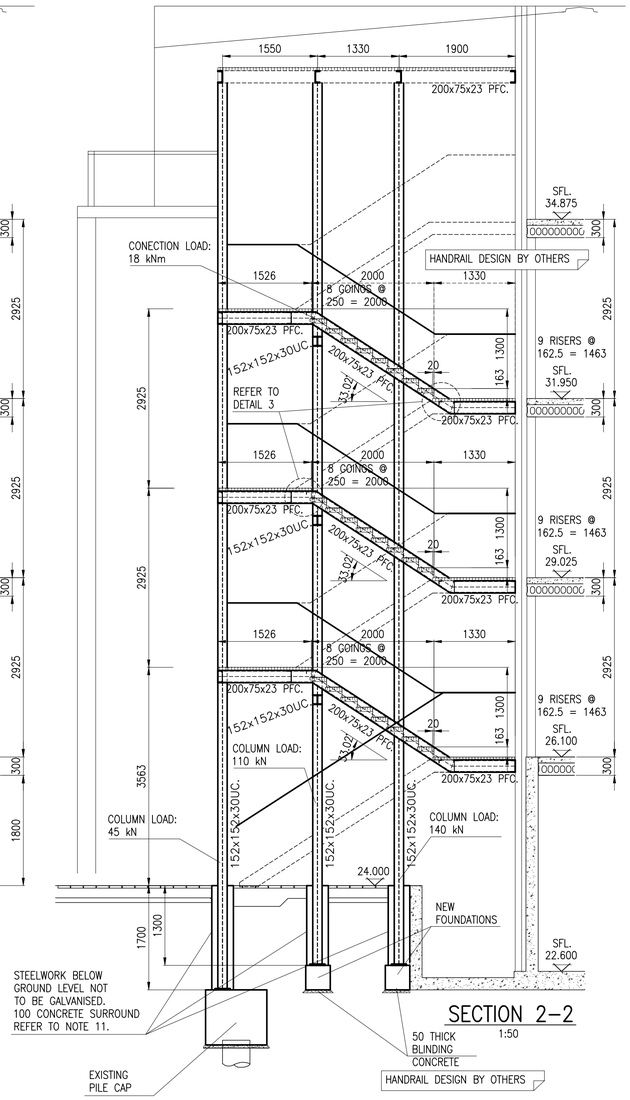

SECTION 2–2
1:50

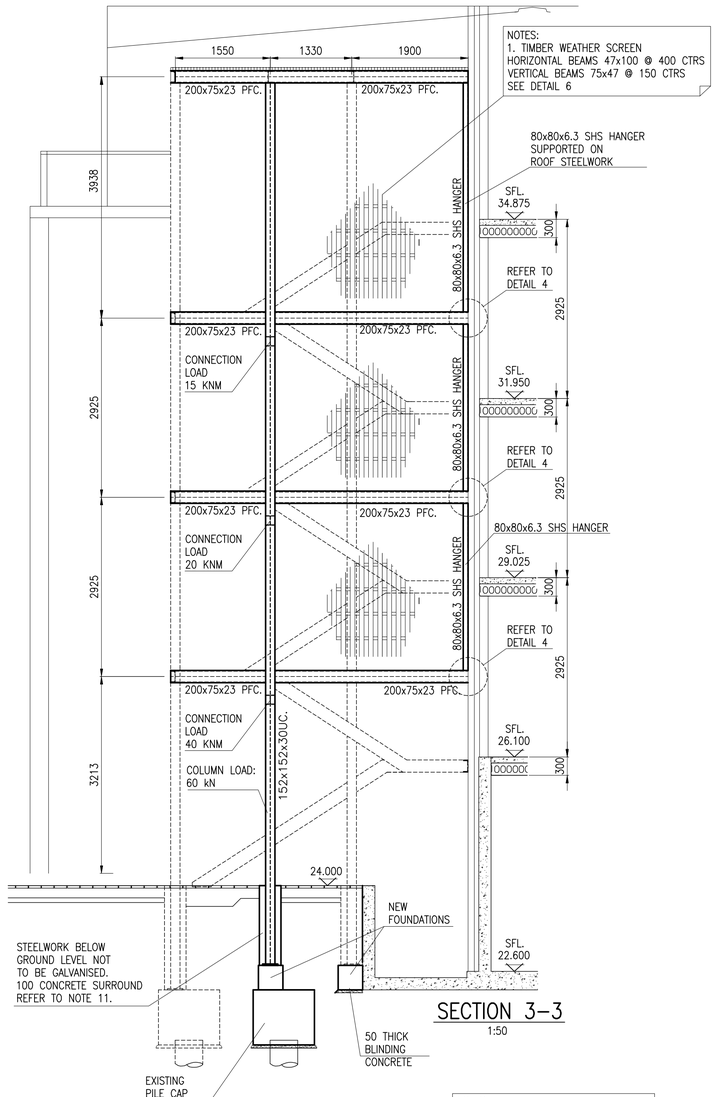

SECTION 3–3
1:50

NOTES:
1. THE STEELWORK FABRICATOR WILL BE RESPONSIBLE FOR TAKING ALL NECESSARY SITE DIMENSIONS FOR FABRICATION PURPOSES.

NOTES

STEELWORK NOTES:

1. ALL STEELWORK TO BE S275 TO BSEN10025 UNLESS NOTED OTHERWISE

2. STEELWORK TO BE DESIGNED, FABRICATED AND ERECTED IN ACCORDANCE WITH SEJC CONSULTING ENGINEERS SPECIFICATION

3. THIS DRAWING TO BE READ IN CONJUNCTION WITH ALL RELEVANT ARCHITECTS AND SEJC CONSULTING ENGINEERS DRAWINGS

4. ALL STEELWORK TO BE GALVANIZED

5. STEELWORK IN MASONRY CAVITIES TO BE GIVEN 2 COATS OF BITUMEN BASED PAINT BY THE MAIN CONTRACTOR AFTER ERECTION UNLESS NOTED OTHERWISE

6. ALL CONNECTIONS TO HAVE A MINIMUM OF 2No M20 BOLTS GRADE 8.8

7. ALL BASEPLATES TO HAVE MINIMUM 4No. HOLDING DOWN BOLTS

8. THE STEELWORK CONTRACTOR SHALL INCLUDE FOR ALL TEMPORARY AND PERMANENT BRACINGS AND ALL NECESSARY TEMPORARY PROPS AND SUPPORTS TO ENSURE TOTAL STABILITY TO THE STRUCTURE AT ALL TIMES

9. THE STEELWORK FABRICATOR WILL BE RESPONSIBLE FOR TAKING ALL NECESSARY SITE DIMENSIONS FOR FABRICATION PURPOSES.

10.THE STEELWORK FABRICATOR WILL BE RESPONSIBLE FOR THE DESIGN OF ALL STEELWORK CONNECTIONS. ALL DRAWINGS AND CALCULATIONS SHALL BE SUBMITTED TO THE STRUCTURAL ENGINEER FOR COMMENTS PRIOR TO FABRICATION OF THE STEELWORK

11.STEELWORK BELOW GROUND FLOOR LEVEL TO BE CLEANED TO SPECIFICATION, UNPAINTED AND CASED IN MINIMUM 100mm THICK CONCRETE UNO

12.FOR POSITIONS AND DETAILS OF HOLDING DOWN BOLTS REFER TO THE STEELWORK CONTRACTORS DRAWINGS

13.THE STEELWORK CONTRACTOR WILL DESIGN, SUPPLY, FABRICATE AND ERECT IN ACCORDANCE WITH THE CURRENT CODES OF PRACTICE

14.INCLUDE FOR ALL TEMPORARY AND PERMANENT BRACINGS AND ALL NECESSARY PROPS AND SUPPORTS TO ENSURE TOTAL STABILITY TO THE STRUCTURE AT ALL TIMES

MK	REVISIONS	BY	DATE	CH'K

STATUS:–
AS BUILT

DRAWN BY _ A.K. DATE FAPRIL 2008
CHECKED BY _ DATE
PROJECT ENGINEER _ _ DATE _ _

CLIENT.
CTP | St JAMES

ARCHITECT.
FaulknerBrowns

CONTRACT
WAKEFIELD WATERFRONT
PHASE 1,
BUILDING 20

SEJC Consulting Engineers
Consulting Structural & Civil Engineers
Sanderson House, Station Road, Horsforth, Leeds LS18 5NT
Telephone 0113 2590090 Fax 0113 2586640

DRAWING TITLE
ESCAPE STAIR

SCALES 1:50 @A1

CONTRACT No 501180C
DRG No 20–210