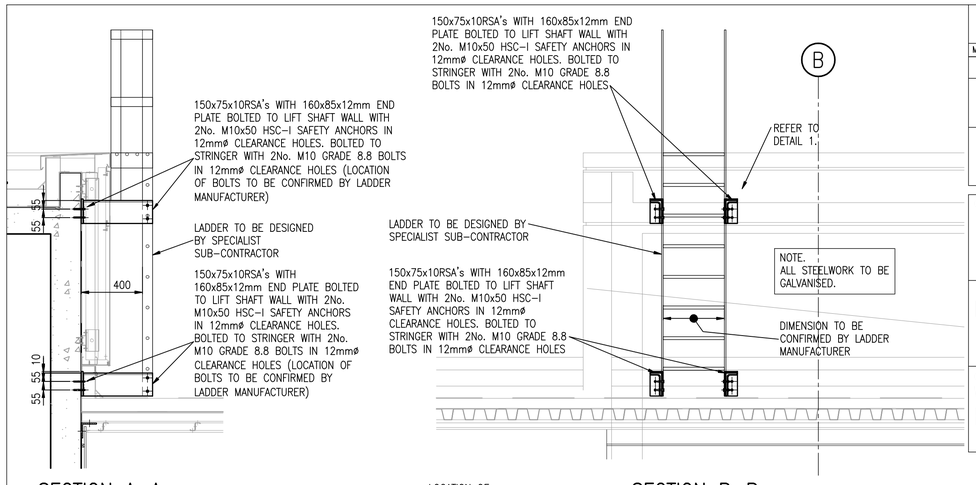

SECTION A–A
(SCALE 1:20)

SECTION B–B
(SCALE 1:20)

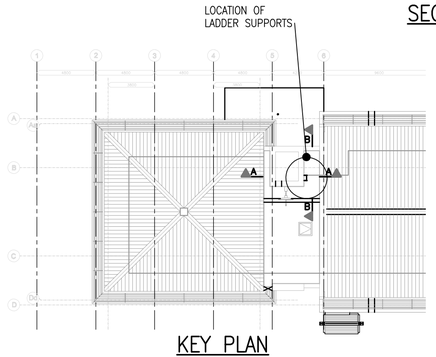

KEY PLAN
(1:250)

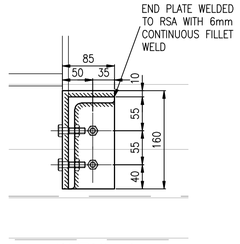

DETAIL 1
(1:5)

MK.	REVISIONS	BY	DATE	CHK'D

STATUS:–

AS BUILT

DRAWN BY MJT DATE 29.05.08
CHECKED BY DATE
PROJECT ENGINEER DATE

CLIENT.
CTP | St JAMES

ARCHITECT.
FaulknerBrowns

CONTRACT
WAKEFIELD WATERFRONT BUILDING 20

SEJC Consulting Engineers
Consulting Structural & Civil Engineers
Sanderson House, Station Road, Horsforth, Leeds LS18 5NT
Telephone 0113 2590090 Fax 0113 2586840

DRAWING TITLE
ACCESS LADDER TO PLANT ROOM ROOF, SUPPORT DETAILS

SCALES AS SHOWN

CONTRACT No 501180C
DRG No 20–225