IT IS THE CONTRACTORS RESPONSIBILITY TO CHECK ALL SETTING OUT DIMENSIONS AND REPORT ANY DISCREPANCY TO THE STRUCTURAL ENGINEER IMMEDIATELY.

CONTRACT No	DRG No
5011801C	20–302

SCALES 1:50, 1:25 (@A0)

DRAWING TITLE
RC. DETAILS OF LOWER BASEMENT SLAB (SSL. 20.400)

SEJC Consulting Engineers
Consulting Structural & Civil Engineers
Stanerton House, Station Road, Hawkeith, Leeds LS18 5NT
Telephone 0113 2590080 Fax 0113 2590840

CONTRACT
WAKEFIELD WATERFRONT PHASE 1, BUILDING 20

ARCHITECT.
FaulknerBrown

CLIENT.
CTP & JAMES

STATUS:–
AS BUILT

DRAWN BY–	CM MASTRY	DATE–	24/08/–
CHECKED BY–		DATE–	
PROJECT ENGINEER–		DATE–	

MK	REVISIONS	BY	DATE	CHK

NOTES.

CONCRETE NOTES
1. ALL MATERIALS AND WORKMANSHIP TO COMPLY WITH S.E.J.C. CONSULTING ENGINEERS STANDARD SPECIFICATION FOR REINFORCED CONCRETE AND ALL RELEVANT BRITISH STANDARDS.
2. THIS DRAWING TO BE READ IN CONJUNCTION WITH ALL RELEVANT ARCHITECTS AND S.E.J.C. CONSULTING ENGINEERS DRAWINGS.
3. ALL REBAT IS LISTED ON BAR SCHEDULE No's 501180/20–302, 01 to 05 INCLUSIVE.
4. COVER TO REINFORCEMENT– 40mm. TO OUTER FACE OF WALLS & 25mm. TO INTERNAL FACES.
40mm. TO BOTTOM REBATT IN SLABS & 25mm. TO TOP.

KEY PLAN
1:100

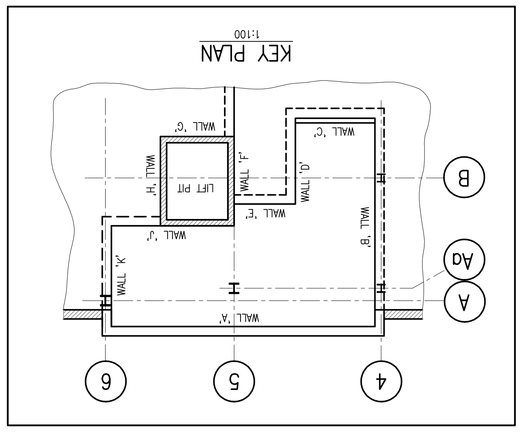

RC. DETAILS OF LOWER–BASEMENT FLOOR SLAB
1:50

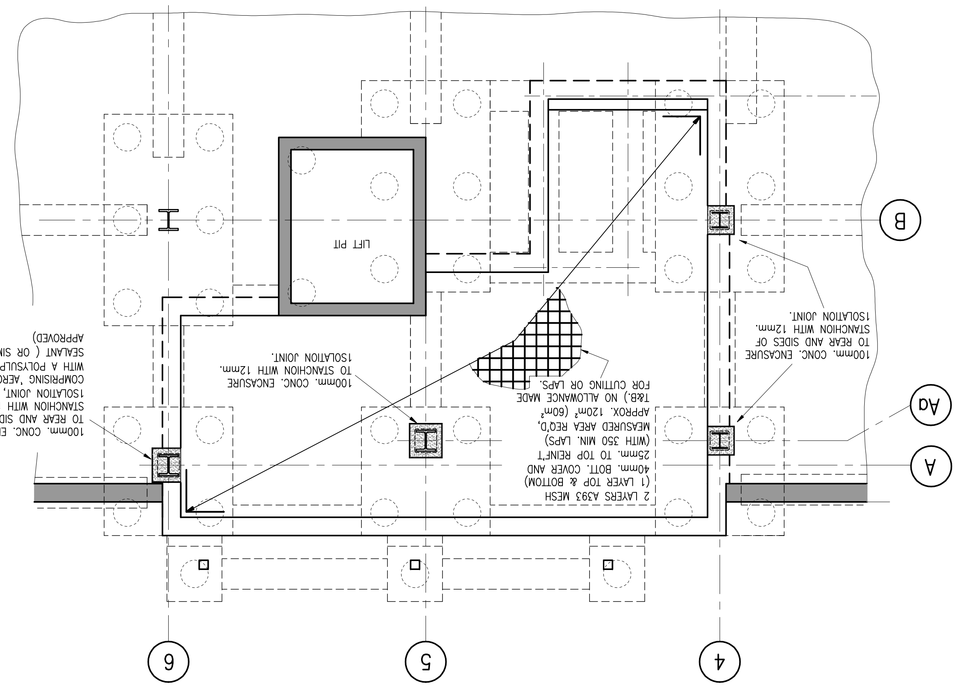

ELEVATION ON WALL 'A'
1:50

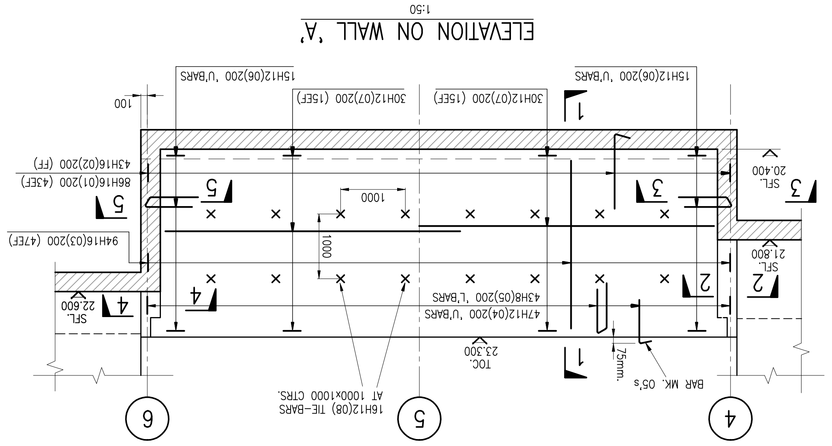
15H12(06)200 'U'BARS
30H12(07)200 (15EF)
1
2
3
4
5
6
7
21.800
SFL
22.600
4
4
7
20.400
SFL
4
7
4
4
4