


EXTERNAL ELEVATION ON WALL ADJ. GRIDLINE 'A'

1:50

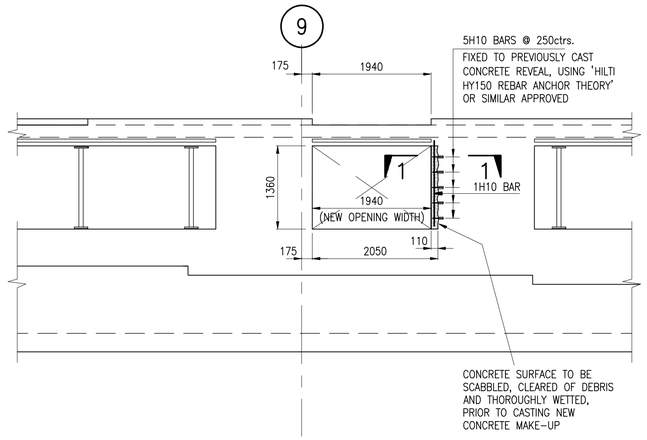


SECTION 1-1

1:10

STATUS:-

AS BUILT

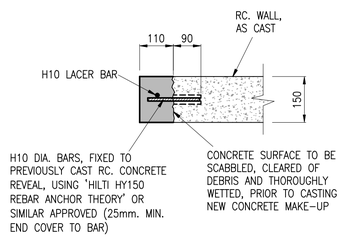DRAWN BY_ SH._____ DATE_ 2.8.07__

CHECKED BY_ _____ DATE_ ____

PROJECT ENGINEER_ ____ DATE_ ____

CLIENT.

CTP | St JAMES

FaulknerBrowns

CONTRACT

WAKEFIELD WATERFRONT
PHASE 1,
BUILDING 20

**SEJC Consulting Engineers**
**Consulting Structural & Civil Engineers**

**Sanderson House, Station Road, Horsforth, Leeds LS18 5NT**
**Telephone 0113 2590090 Fax 0113 2586640**

DRAWING TITLE

MODIFICATION TO
BASEMENT WALL OPENING,
ADJ. GRIDLINES A/9

SCALES 1:50, 1:10

CONTRACT No 501180C

DRG No 20-313