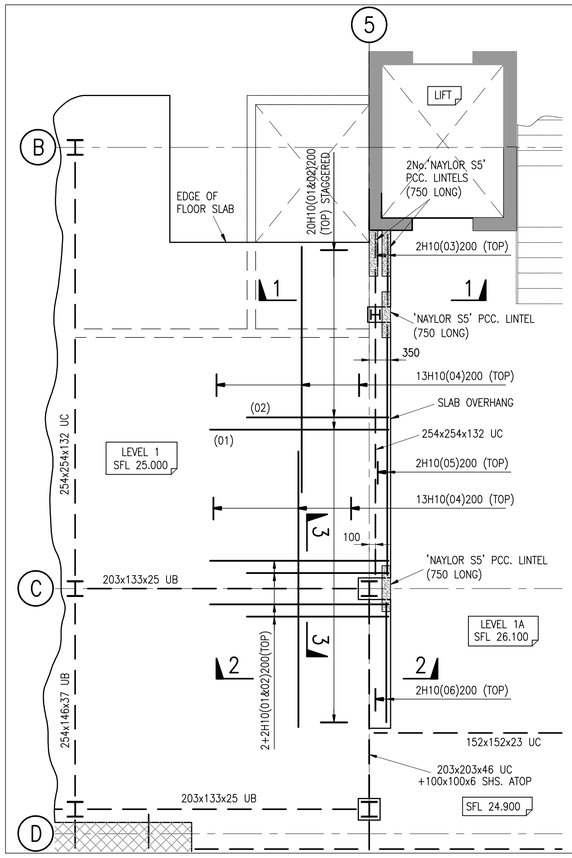

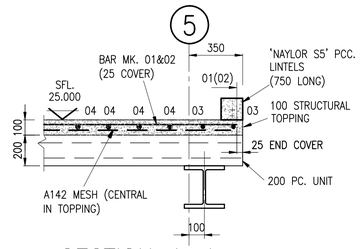

SECTION 1–1

(SCALE 1:20)

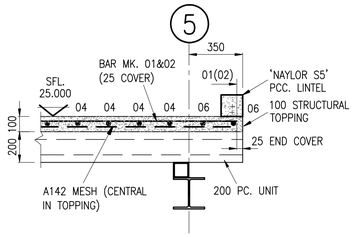

SECTION 2–2

(SCALE 1:20)

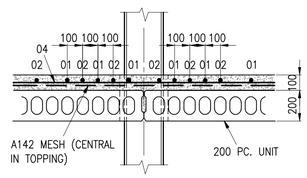

SECTION 3–3

(SCALE 1:20)

STATUS:–
AS BUILT

DRAWN BY SH DATE 'OCT.'07
CHECKED BY DATE
PROJECT ENGINEER DATE

CLIENT.
CTP St JAMES

ARCHITECT
FaulknerBrowns

CONTRACT
WAKEFIELD WATERFRONT
PHASE 1,
BUILDING 20

SEJC Consulting Engineers
Consulting Structural & Civil Engineers

Sanderson House, Station Road, Horsforth, Leeds LS18 5NT
Telephone 0113 2590090 Fax 0113 2588640

DRAWING TITLE
RC. DETAILS FOR STRUCTURAL TOPPING AT LEVEL 1, GRIDLINE 5/B–D

SCALES 1:50,1:20 (@A3)

CONTRACT No 501180C
DRG No 20–316