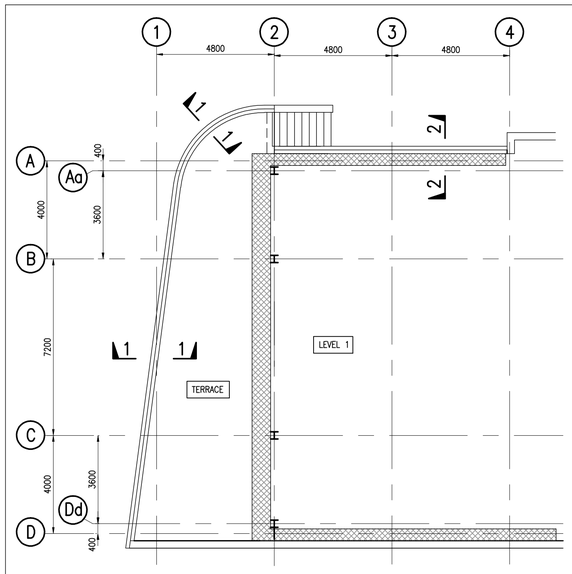

ALL INFILL CONCRETE GRADE C40 (40mm. MIN. COVER TO REINF'T

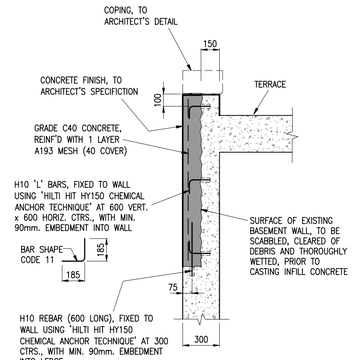

SECTION 1–1
1:20

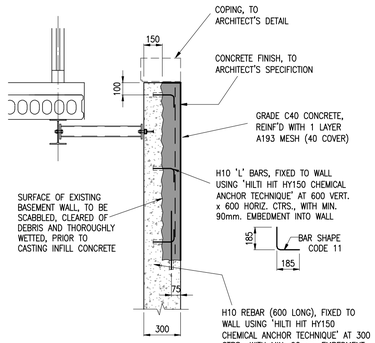

SECTION 2–2
1:20

STATUS:–
AS BUILT

DRAWN BY SH DATE APR.'08
CHECKED BY DATE
PROJECT ENGINEER DATE

CLIENT.
CTP St JAMES

ARCHITECT
FaulknerBrowns

CONTRACT
WAKEFIELD WATERFRONT PHASE 1, BUILDING 20

SEJC Consulting Engineers
Consulting Structural & Civil Engineers

Sanderson House, Station Road, Horsforth, Leeds LS18 5NT
Telephone 0113 2590090 Fax 0113 2589640

DRAWING TITLE
RC. DETAILS FOR CONCRETE INFILL, TO UPPER SECTION OF EXTERNAL RADIAL, END & SIDE WALLS.

SCALES 1:125,1:20 (@A3)

CONTRACT No 501180C
DRG No 20–321