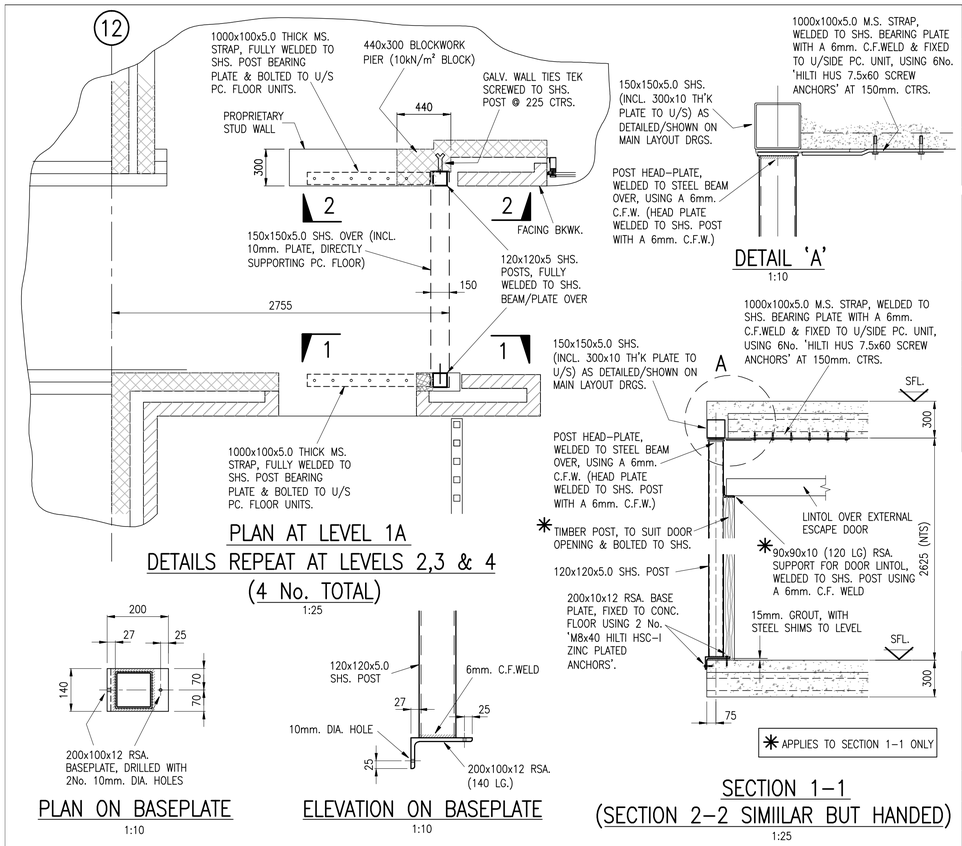

STATUS:-
AS-BUILT

DRAWN BY SH. DATE OCT. 07
CHECKED BY DATE
PROJECT ENGINEER DATE

CLIENT.
CTP St JAMES

ARCHITECT
FaulknerBrowns

CONTRACT
WAKEFIELD WATERFRONT, PHASE 1, BUILDING 20

SEJC Consulting Engineers
Consulting Structural & Civil Engineers
Sanderson House, Station Road, Horsforth, Leeds LS18 5NT
Telephone 0113 2590090 Fax 0113 2586640

DRAWING TITLE
RESTRAINT DETAILS TO CORRIDOR END WALL, GRIDS 12-13

SCALES 1:25, 1:10 (@ A3)

CONTRACT No 501180C
DRG No 20-SK06