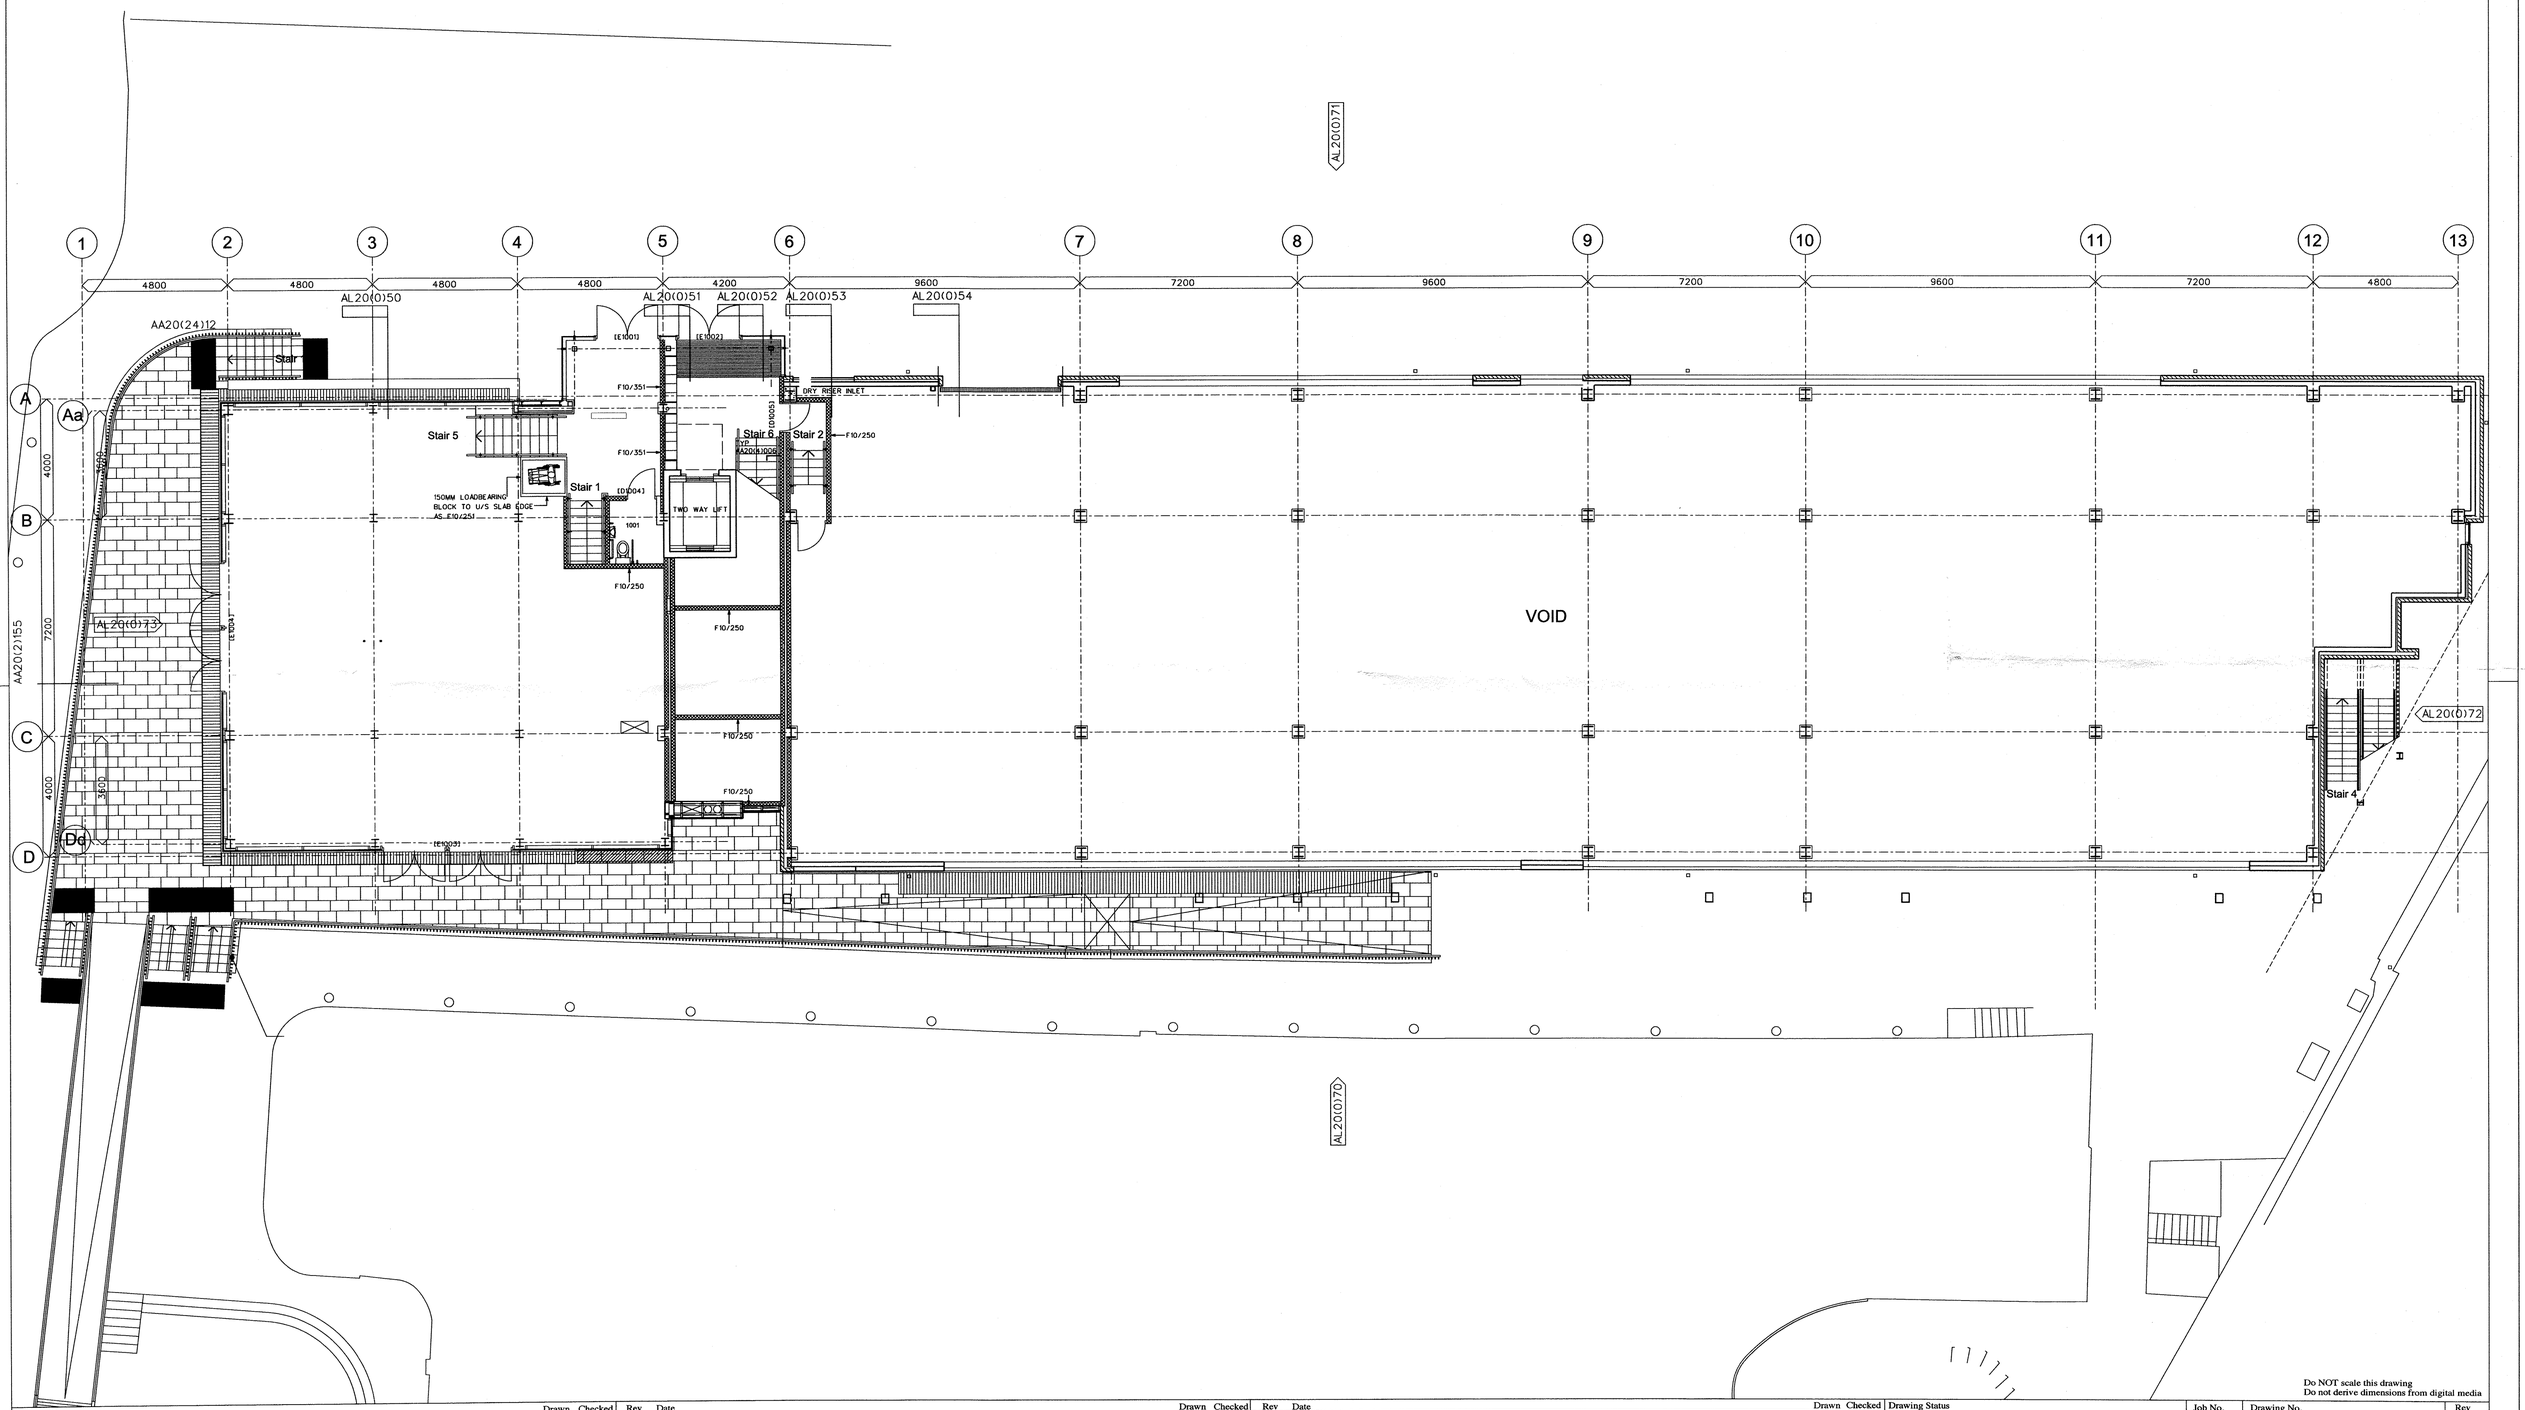

Do NOT scale this drawing
Do not derive dimensions from digital media

Rev	Date		Drawn	Checked
	02.09.05	ISSUED FOR PLANNING		
A	01.11.05	WATERSIDE MARGIN INCREASED TO 2.5M, VENTILATION GRILLE AMENDED, ENTRANCE TO CAFE AND APARTMENTS AMENDED	RW	BS
	01.11.05	ISSUED FOR PLANNING		
B	20.03.06	RESTAURANT LAYOUT REMOVED (FIT OUT ITEM), VENTILATION SIZE TO CAR PARK AROUND RESTAURANT INCREASED IN AREA	AB	RW
	20.03.06	REV B-ISSUED FOR COSTING		
C	05.06.06	WALL BUILD UPS INDICATED ON DRAWING, STAIRS UPDATED, NOTES REVISED IN ACCORDANCE WITH CHANGES, STRUCTURAL GRID UPDATED	KB	RW
	07.06.06	ISSUED FOR TENDER		

Rev	Date		Drawn	Checked
D	13.06.06	MAIN AL SECTION REFERENCES CORRECTED TO (0) NOT (1) GUTTERS ADDED AT RESTAURANT	AB	RW
	16.06.06	REV D - ISSUED FOR TENDER		
E	19.01.07	RWP's, HANDRAIL TO STAIR 12, & NOTE TO EXT STR ADDED. GRIDS RELEVANT TO LEVEL 4 OMITTED.	NBr	RW
	26.01.07	REV E - ISSUED FOR CONSTRUCTION		
F	21.05.07	EXTENT OF VENTILATION GRILLE AMENDED. RWP POSITION AMENDED & NOTE ADDED BRICKWORK UPDATED TO SUIT INCREASED CAVITY SIZE.	NE	RW
G	04.10.07	BLOCKWORK TO STAIRS REDUCED TO 100mm	JD	NBr
H	15.10.07	DRY RISER INLET INDICATED ADJACENT TO GRID LINE 6.	JD	RW
J	17.03.08	LANDING LOCATION CONFIRMED ON EXTERNAL RAMPED ACCESS.	NBr	RW

Rev	Date		Drawn	Checked
K	08.09.08	AS BUILT ISSUE	NBr	RW

Drawing Status: AS BUILT

Job Title: WAKEFIELD WATERFRONT PHASE 1A

Drawing Title: RESIDENTIAL BLOCK - LEVEL 1

Date	Scale	Drawn	Checked
16.06.06	1:100@A1	AB	RW

Job No. 1864 | Drawing No. AL20(0) 100 | Rev K

© Drawing and design copyright of:

FaulknerBrowns Architects
Dobson House
Northumbrian Way
Killingworth
Newcastle upon Tyne
NE12 6QW.
Telephone 0191 268 3007
Fax 0191 268 5227