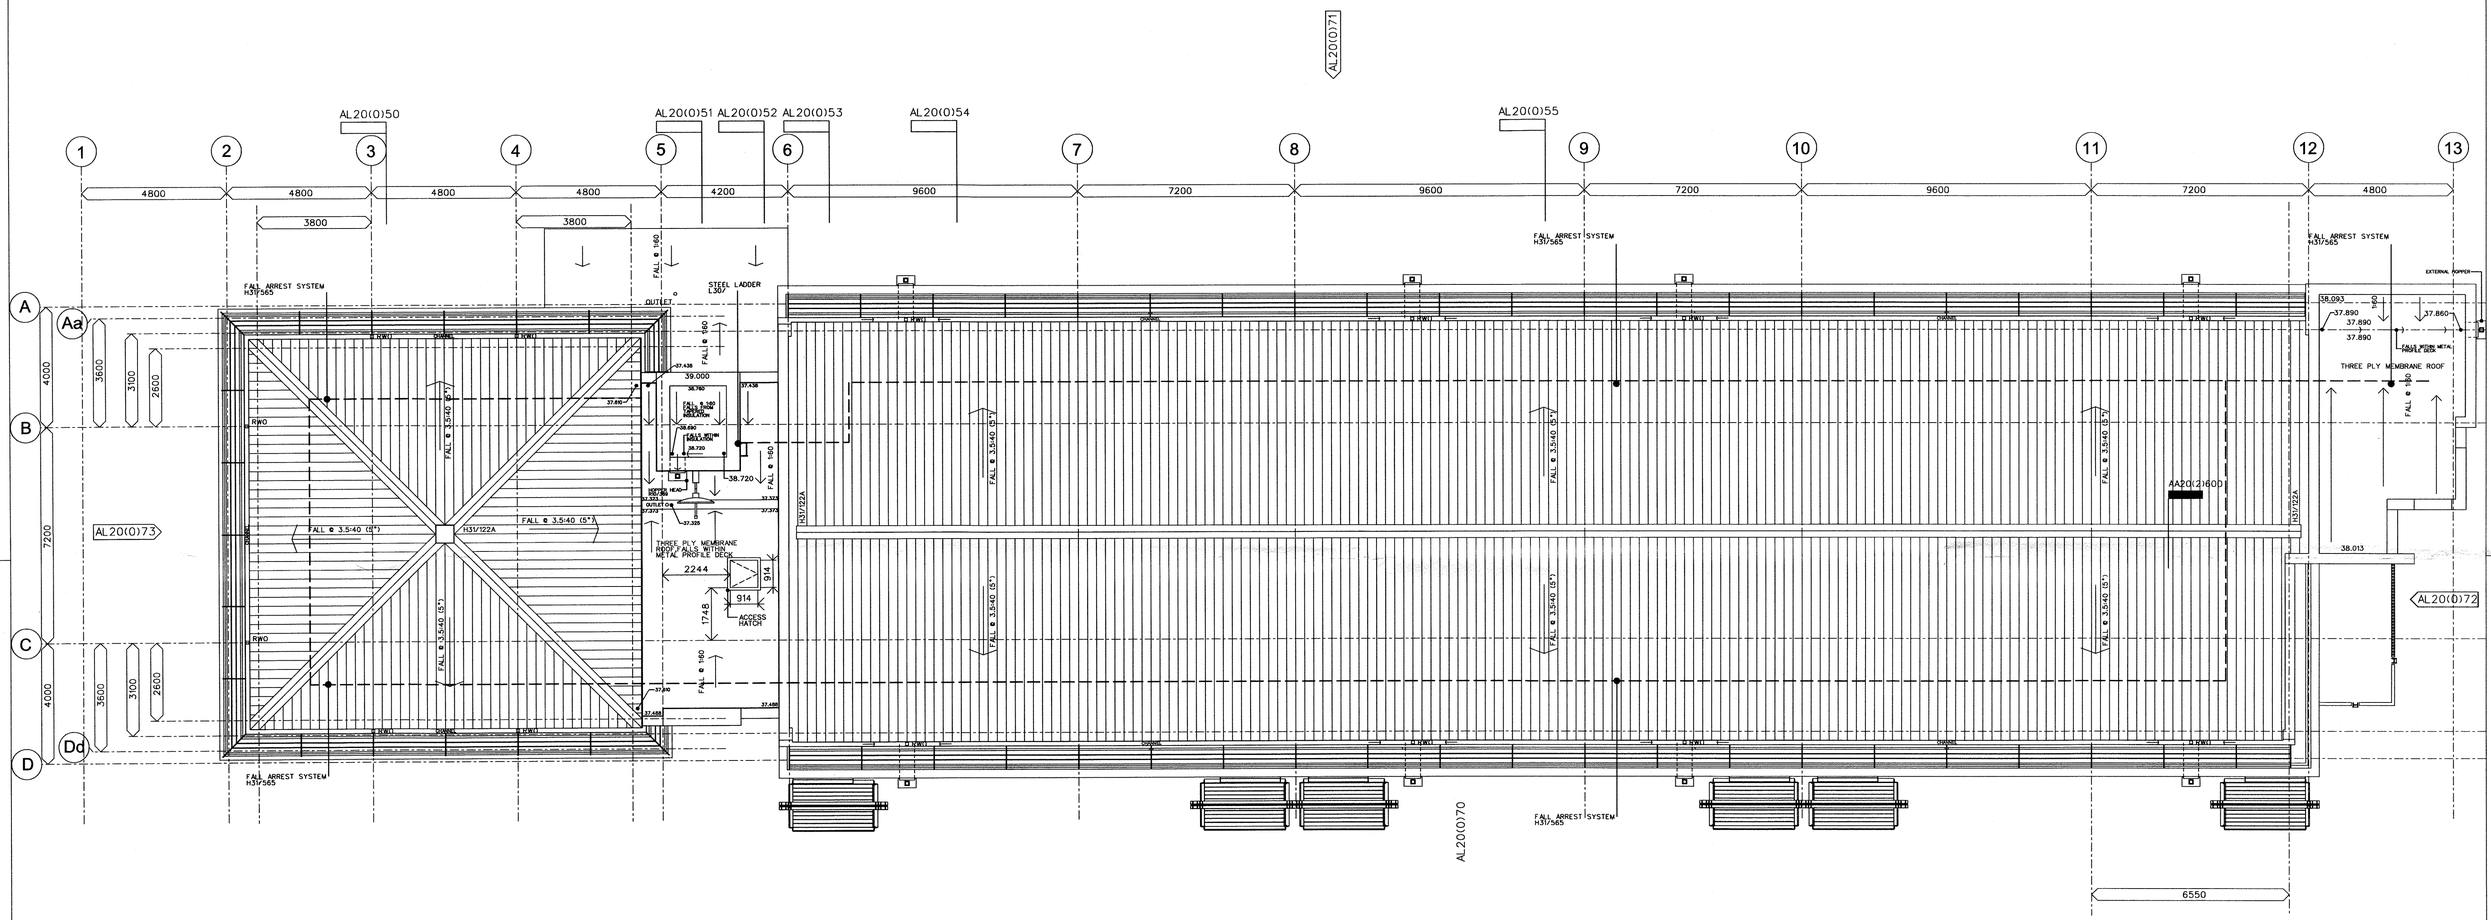

Do NOT scale this drawing
Do not derive dimensions from digital media

Rev	Date		Drawn	Checked
	07.06.06	ISSUED FOR TENDER		
A	13.06.06	MAIN AL SECTION REFERENCES CORRECTED TO (0) NOT (1)	AB	RW
	16.06.06	REV A - ISSUED FOR TENDER		
B	25.01.07	MANSAFE & ROOF ACCESS LADDER ADDED		
	26.01.07	REV B - ISSUED FOR CONSTRUCTION		
C	04.06.07	ROOF NOTES AMENDED, DETAIL REF ADDED	NE	RW
D	06.02.08	ROOF HATCH SETTING OUT ADDED.	NBr	RW
E	08.09.08	AS BUILT ISSUE	NBr	RW
—	—		—	—
—	—		—	—



Drawing Status: AS BUILT

Job No.: 1864

Drawing No.: AL20(0) 500

Rev: E

Job Title: WAKEFIELD WATERFRONT PHASE 1A

Drawing Title: RESIDENTIAL BLOCK 20 - ROOF PLAN

Date	Scale	Drawn	Checked
16.06.06	100@A1	RW	BS

© Drawing and design copyright of:

FaulknerBrowns Architects
Dobson House
Northumbrian Way
Killingworth
Newcastle upon Tyne
NE12 6QW.
Telephone 0191 268 3007
Fax 0191 268 5227